

**MARSHALL**  
**N 2016**  
**5-2-77**

MISSISSIPPI  
 BOARD OF WATER COMMISSIONERS  
 416 North State Street  
 Jackson, Mississippi 39201

WATER WELL DRILLERS LOG

5-2  
 date well completed

1977 Earl Jones Well Co  
 firm name


Marshall  
 county well located

| LANDOWNER:   | description of formations encountered | from | to  |
|--|---------------------------------------|------|-----|
| Susie Richmond   |                                       |      |     |
| Byhalia Miss. Rd.<br>(mailing address)   | Topsoil & clay                        | 10   | 14  |
|  | sand                                  | 14   | 42  |
|  | clay                                  | 42   | 58  |
|  | hard                                  | 58   | 105 |
| WELL LOCATION:   |                                       |      |     |
| sec. 6 T. 4 N. R. 4 E.<br>S. W.<br>3 3/4 miles N.W. of Mericoma<br>(distance) (direction) (nearest town) |                                       |      |     |
| WELL PURPOSE: Home<br>(home, irrigation, municipal, industrial)  |                                       |      |     |
| WELL COMPLETION DATA:  |                                       |      |     |
| (1) diameter (inches) 4"   |                                       |      |     |
| (2) total depth (feet) 105'  |                                       |      |     |
| (3) static water level (feet) 70' below top of ground.   |                                       |      |     |
| (4) casing plastic 95'<br>(material) (depth)<br>4" (size) if telescope see back.                         |                                       |      |     |
| (5) screen 10' 95'<br>(length) (depth to top)  |                                       |      |     |
| 4" - 0.13 plastic<br>(size) (material)   |                                       |      |     |
| (6) pump 1/2 17<br>(HP) (yield gpm)<br>Electric<br>(type power)  |                                       |      |     |
| (7) electric log no<br>(yes or no)   |                                       |      |     |
| (organization running log)   |                                       |      |     |
| (8) how well bottom plugged plastic cap  |                                       |      |     |
| DRILLERS REMARKS:  |                                       |      |     |

**RECEIVED**  
 MAY 10 1977

If well telescopes please sketch and show depths.

GROUND LEVEL

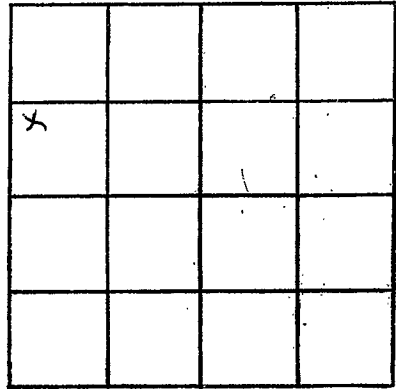

SECTION 16

Please indicate well location X.

ADDITIONAL INFORMATION

If more than one screen, show locations of each on sketch.