

**MARSHALL**  
 N 2077  
 6-2-77

MISSISSIPPI  
 BOARD OF WATER COMMISSIONERS  
 416 North State Street  
 Jackson, Mississippi 39201

WATER WELL DRILLERS LOG

6-2 1977 Dean Kent Driller well Marshall  
 date well completed firm name county well located

LANDOWNER:  
Autry P. Allen  
at 453 Bayouline, Miss.  
 (mailing address)

description of formations encountered	from	to
<u>clay</u>	<u>0</u>	<u>120</u>
<u>sand</u>	<u>120</u>	<u>170</u>

WELL LOCATION:  
 sec. 14 T. 4 N. R. 7 E.  
 (S) (W)  
2 1/2 miles NORTH of MAR-ANN  
 (distance) (direction) (nearest town)

WELL PURPOSE: Drinking  
 (home, irrigation, municipal, industrial)


- WELL COMPLETION DATA:
- (1) diameter (inches) 4"
  - (2) total depth (feet) 170 feet
  - (3) static water level (feet) 120 below top of ground.
  - (4) casing pvc, 170 feet  
 (material) (depth)
  - (size) if telescope see back.
  - (5) screen 7ft., 16 3/4 feet  
 (length) (depth to top)
  - 4", gravel wall  
 (size) (material)
  - (6) pump 3/4, 14  
 (HP) (yield gpm)
  - (type power)
  - (7) electric log stat.  
 (yes or no)
  - (organization running log)
  - (8) how well bottom plugged 4" cp.

DRILLERS REMARKS:

**RECEIVED**  
 JUL 11 1977  
 MISS. BD. OF WATER COM. 1977

If well telescopes please sketch and show depths.

GROUND LEVEL

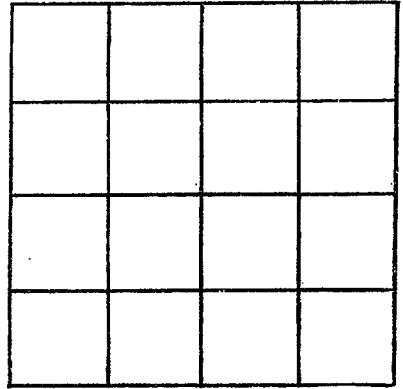

SECTION \_\_\_\_\_

Please indicate well location X.

ADDITIONAL INFORMATION

If more than one screen,  
show locations of each on sketch.