

Marshall  
N 2019  
8/4/77

MISSISSIPPI  
BOARD OF WATER COMMISSIONERS  
416 North State Street  
Jackson, Mississippi 39201

WATER WELL DRILLERS LOG

8-4-77 date well completed      W.A. Mason Waterwell Center firm name      Marshall county well located

LANDOWNER:  
Beauty McCrawen Beep  
St. Louis Missouri  
(mailing address)

description of formations encountered	from	to
clay silt	10	12
white sand	12	90

WELL LOCATION:  
sec. 7 T. 4 N R. 4 E  
1/2 miles S E of Watson  
(distance) (direction) (nearest town)

WELL PURPOSE: Home  
(home, irrigation, municipal, industrial)

- WELL COMPLETION DATA:
- (1) diameter (inches) 4"
  - (2) total depth (feet) 90'
  - (3) static water level (feet) 45' below top of ground. ~~above~~
  - (4) casing (material) (depth)  
Plastic 80'
  - 4" (size) if telescope see back.
  - (5) screen (length) (depth to top)  
10' 80'
  - 4" (size) Plastic (material)
  - (6) pump (HP) (yield gpm)  
3/4 10
  - electric (type power)
  - (7) electric log (yes or no) No

(organization running log)  
(8) how well bottom plugged Cap

DRILLERS REMARKS:


RECEIVED

DEC 12 1977

MISS. BD. OF WATER COMMISSIONERS

If well telescopes please sketch and show depths.

GROUND LEVEL

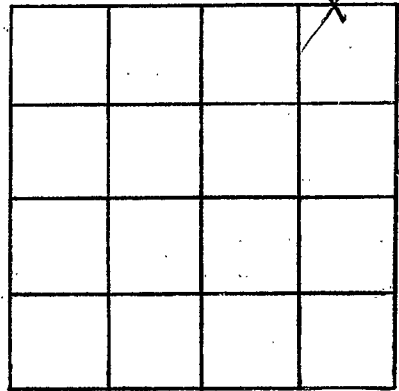

SECTION 7

Please indicate well location X.

ADDITIONAL INFORMATION

If more than one screen, show locations of each on sketch.