

Marshall
 N 2000
 9-24-77

MISSISSIPPI
 BOARD OF WATER COMMISSIONERS
 416 North State Street
 Jackson, Mississippi 39201

15E

WATER WELL DRILLERS LOG

9-24-19 77 Rick Well Co Marshall
 date well completed firm name county well located

LANDOWNER: <u>Charles Faulkner</u> <u>Rt. 3</u>	description of formations encountered	from	to
<u>Bay Station, Ms.</u> (mailing address)	<u>Red clay</u>	<u>0</u>	<u>30</u>
WELL LOCATION: sec. <u>19</u> T <u>4</u> N R <u>4</u> E <u>7</u> miles <u>NE</u> of <u>Wynette</u> (distance) (direction) (nearest town)	<u>Red Clay + Sand</u>	<u>30</u>	<u>140</u>
WELL PURPOSE: <u>Home</u> (home, irrigation, municipal, industrial)	<u>white clay</u>	<u>140</u>	<u>180</u>
WELL COMPLETION DATA: (1) diameter (inches) <u>4</u> (2) total depth (feet) <u>180</u> (3) static water level (feet) <u>130</u> below above top of ground. (4) casing <u>RVC</u> , <u>180</u> , (material) (depth) (size) if telescope see back. (5) screen <u>7</u> , <u>173</u> (length) (depth to top) <u>4</u> , <u>spawel type</u> (size) (material) (6) pump <u>40</u> , <u>10</u> (HP) (yield gpm) <u>220V</u> (type power) (7) electric log <u>No</u> (yes or no) (organization running log) (8) how well bottom plugged <u>Cap</u>			
DRILLERS REMARKS:			


RECEIVED

OCT 17 1977

MISS. BD. OF WATER COMMISSIONERS

If well telescopes please sketch and show depths.

GROUND LEVEL

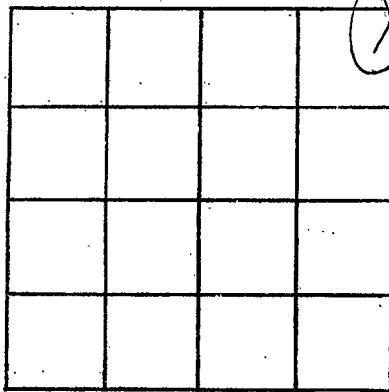

SECTION 19

Please indicate well location X.

ADDITIONAL INFORMATION

If more than one screen, show locations of each on sketch.