

Marshall
 N 2022
 10/20/77

MISSISSIPPI
 BOARD OF WATER COMMISSIONERS
 416 North State Street
 Jackson, Mississippi 39201

WATER WELL DRILLERS LOG

10-30 1977 Demoffert Brothers Marshall
 date well completed firm name county well located

LANDOWNER:

Alex Jayner
Rt. 4, Byhalia, Miss
 (mailing address)

description of formations encountered

from to

Clay 0 140
Sand 140 190

WELL LOCATION:

sec. 14 T. 7 N. R. 4 E.
4 miles North of Marion
 (distance) (direction) (nearest town)

WELL PURPOSE: Drinking
 (home, irrigation, municipal, industrial)

WELL COMPLETION DATA:

- (1) diameter (inches) 4"
- (2) total depth (feet) 190 feet
- (3) static water level (feet) 110 below top of ground.
- (4) casing PVC, 190 feet
 (material) (depth)
 (size) if telescope see back.
- (5) screen 7 ft., 183 feet
 (length) (depth to top)
4", gravel
 (size) (material)
- (6) pump 3/4, 14
 (HP) (yield gpm)
 (type power)
- (7) electric log Elect.
 (yes or no)
 (organization running log)
- (8) how well bottom plugged 4" CP


RECEIVED
 NOV - 4 1977

MISS. BD. OF WATER COMMISSIONERS

DRILLERS REMARKS:

If well telescopes please
sketch and show depths.

GROUND LEVEL

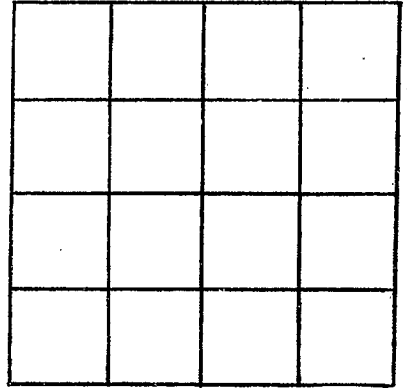

SECTION _____

Please indicate well location X.

ADDITIONAL INFORMATION

If more than one screen,
show locations of each on sketch.