

MARSHALL

N 224

MISSISSIPPI BOARD OF WATER COMMISSIONERS
416 North State Street
Jackson, Mississippi 39201

WATER WELL DRILLERS LOG

6-27-78 date well completed
Hicks Well Co firm name
Marshall county well located

LANDOWNER: Louise Davis

Rt. 4

Byhalia, Ms.
(mailing address)

description of formations encountered

from to

Red Clay 0 10

White Clay & Sand 10 90

White Clay 90 108

White Sand 100 155

WELL LOCATION:

sec. 17 T 4 N R 4 E
7 miles NE of Wynthle
(distance) (direction) (nearest town)

WELL PURPOSE: Home
(home, irrigation, municipal, industrial)

WELL COMPLETION DATA:

(1) diameter (inches) 4

(2) total depth (feet) 155

(3) static water level (feet) 90 below top of ground.

(4) casing PVC, 155, (material) (depth)

(size) If telescope see back.

(5) screen 7, 148 (length) (depth to top)

4" gravel type (size) (material)

(6) pump 1/2, 10 (HP) (yield gpm)


220V (type power)

(7) electric log No (yes or no)

(organization running log)

(8) how well bottom plugged Cap

DRILLERS REMARKS:

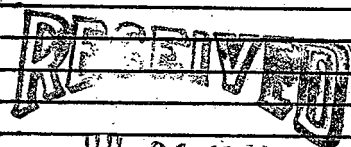

JUL 21 1978

MISS. BD. OF WATER COMM

If well telescopes please sketch and show depths.

GROUND LEVEL

| | | | |
|---|--|--|--|
| | | | |
| | | | |
| | | | |
| X | | | |

SECTION 17

Please indicate well location X.

ADDITIONAL INFORMATION

If more than one screen,
show locations of each on sketch.