


MARSHALL
N
8-19-78
2025

**MISSISSIPPI
BOARD OF WATER COMMISSIONERS**
416 North State Street
Jackson, Mississippi 39201

WATER WELL DRILLERS LOG

Aug 19 1978 Earl Jones Well Co. Marshall
 date well completed firm name county well located


LANDOWNER:	description of formations encountered	from	to
<u>L.C. Bennett</u>			
<u>Byhalia Miss. Rt 4</u> (mailing address)	<u>sandy loam</u>	<u>0</u>	<u>5</u>
	<u>clay</u>	<u>5</u>	<u>18</u>
	<u>sand.</u>	<u>18</u>	<u>45</u>
	<u>clay</u>	<u>45</u>	<u>60</u>
	<u>sand.</u>	<u>60</u>	<u>88</u>
WELL LOCATION:			
sec <u>3</u> T <u>4</u> N R <u>4</u> E <u>5</u> S <u>2</u> W (distance) miles (direction) of <u>Victorio</u> (nearest town)			
WELL PURPOSE: <u>Home</u> (home, irrigation, municipal, industrial)			
WELL COMPLETION DATA:			
(1) diameter (inches) <u>2"</u>			
(2) total depth (feet) <u>88</u>			
(3) static water level (feet) <u>54</u> below top of ground.			
(4) casing <u>plastic 78</u> (material) (depth) <u>2"</u> (size) if telescope see back.			
(5) screen <u>10'</u> <u>78</u> (length) (depth to top) <u>2"-013</u> <u>plastic</u> (size) (material)			
(6) pump <u>3/4</u> <u>4</u> (HP) (yield gpm) <u>electric</u> (type power)			
(7) electric log <u>no</u> (yes or no)			
(organization running log)			
(8) how well bottom plugged <u>plastic cap</u>			
DRILLERS REMARKS:			

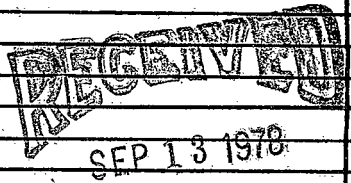

MISS. BD. OF WATER COMMISSIONERS

If well telescopes please sketch and show depths.

GROUND LEVEL

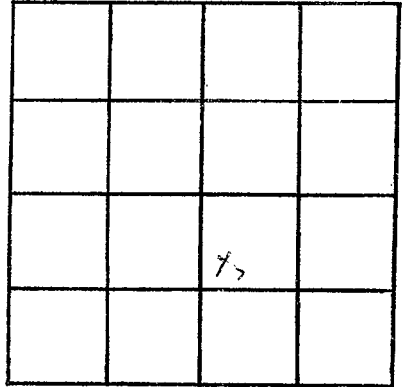

SECTION 3

Please indicate well location X.

ADDITIONAL INFORMATION

If more than one screen,
show locations of each on sketch.