

MARSHALL

MARTON

N

12-14-78

2026

MISSISSIPPI
BOARD OF WATER COMMISSIONERS
416 North State Street
Jackson, Mississippi 39201

WATER WELL DRILLERS LOG

date well completed

firm name

county well located

12-14-78 Hicks Well Co. Marshall

LANDOWNER:

Tony Dockery

description of formations encountered

from

to

Rt. 4, Box 19

Red Clay

0 10

Buhala's, Ms.
(mailing address)

Red Sand

10 30

WELL LOCATION:

sec. 7 T 4 N R 4 E
4 miles SE of Water
(distance) (direction) (nearest town)

White Sand

30 135

WELL PURPOSE:

Home
(home, irrigation, municipal, industrial)


WELL COMPLETION DATA:

- (1) diameter (inches) 4
- (2) total depth (feet) 135
- (3) static water level (feet) 115 below above top of ground.
- (4) casing PVC, 135, (material) (depth)
- (size) if telescope see back.
- (5) screen 4' 128 (length) (depth to top)
- 4" gravel type (size) (material)
- (6) pump 1/2 10 (HP) (yield gpm)
- 220V (type power)
- (7) electric log No (yes or no)

(organization running log)

(8) how well bottom plugged Cap

DRILLERS REMARKS:

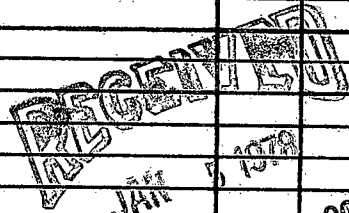

MISS. BD. OF WATER COMMISSIONERS

