

Marshall  
N  
8-28-79  
2036

MISSISSIPPI  
BOARD OF WATER COMMISSIONERS  
416 North State Street  
Jackson, Mississippi 39201

WATER WELL DRILLERS LOG

8-28 1979 Nichs Well Co. Marshall  
date well completed firm name county well located

LANDOWNER:  
W. Orrell Sumler  
Rt. 4, Box 160 D Byhalia  
(mailing address)

description of formations encountered	from	to
<u>Red Clay</u>	<u>0</u>	<u>20</u>
<u>Red sand</u>	<u>20</u>	<u>100</u>
<u>White sand</u>	<u>100</u>	<u>155</u>

WELL LOCATION:  
sec. 18 T 4 N R 4 E  
1 1/2 miles S of Marshall  
(distance) (direction) (nearest town)

WELL PURPOSE: Home  
(home, irrigation, municipal, industrial)

- WELL COMPLETION DATA:
- (1) diameter (inches) 4 in
  - (2) total depth (feet) 155
  - (3) static water level (feet) \_\_\_\_\_ below above top of ground.
  - (4) casing Plastic 155  
(material) (depth)  
(size) if telescope see back.
  - (5) screen 7 ft 1 1/8  
(length) (depth to top)  
4 in bravel  
(size) (material)
  - (6) pump 1/2 10  
(HP) (yield gpm)  
220  
(type power)
  - (7) electric log No  
(yes or no)
  - (organization running log)
  - (8) how well bottom plugged Cap

DRILLERS REMARKS:


Miss. Board of Water Comm.

SEP 11 1979

RECEIVED

If well telescopes please sketch and show depths.

GROUND LEVEL

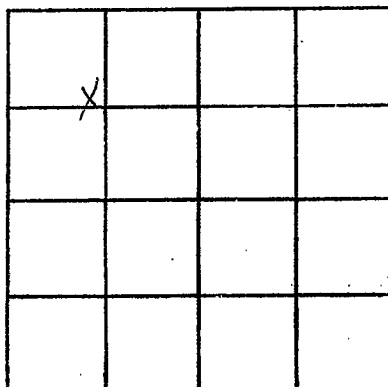

SECTION 18

Please indicate well location X.

ADDITIONAL INFORMATION

If more than one screen, show locations of each on sketch.