

Marshall
N
231
12-8-79

MISSISSIPPI
BOARD OF WATER COMMISSIONERS
416 North State Street
Jackson, Mississippi 39201

WATER WELL DRILLERS LOG


Dec 8 1979 Earl Jones Well Co Marshall
date well completed firm name county well located

LANDOWNER:	description of formations encountered	from	to
Howard Crone			
Bryhalia Miss. RT 1 (mailing address)	Topsoil -	0	4
	sand	4	45
	clay	45	50
	sand	50	62
	clay	62	65
	sand	65	88
WELL LOCATION: sec 32 T 4 N R 4 E S W 3 1/2 miles S W of Mariano (distance) (direction) (nearest town)			
WELL PURPOSE: Home (home, irrigation, municipal, industrial)			
WELL COMPLETION DATA:			
(1) diameter (inches) 4"			
(2) total depth (feet) 88			
(3) static water level (feet) 62 below top of ground.			
(4) casing plastic 78 (material) (depth) 4" if telescope see back. (size)			
(5) screen 10' 78 (length) (depth to top) D13-4 plastic (size) (material)			
(6) pump 1/2 15 (HP) (yield gpm) electric (type power)			
(7) electric log no (yes or no) (organization running log)			
(8) how well bottom plugged plastic cap			
DRILLERS REMARKS:			

Rec'd
J.W.
12/27/79

If well telescopes please sketch and show depths.

GROUND LEVEL

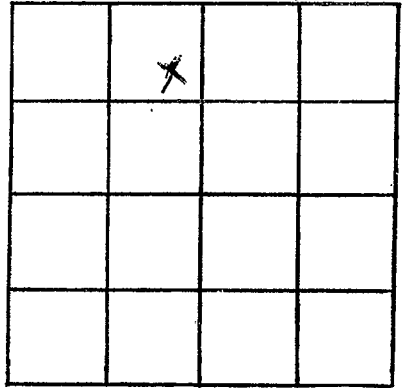

SECTION 32

Please indicate well location X.

ADDITIONAL INFORMATION

If more than one screen,
show locations of each on sketch.