

MARSHALL
N 2032

MISSISSIPPI
BOARD OF WATER COMMISSIONERS
416 North State Street
Jackson, Mississippi 39201

WATER WELL DRILLERS LOG

3-26-80
3-26

1980 Richs Well Co.

Marshall

date well completed

firm name

county well located

LANDOWNER:	description of formations encountered	from	to
Stuckland Chapel Rt. 3, B hysala Miss. (mailing address)	clay	0	30
WELL LOCATION: sec. 30 T 4 N R 4 E 4 miles N of 309 (distance) (direction) (nearest town)	Red sand	30	90
WELL PURPOSE: home (home, irrigation, municipal, industrial)	white sand	90	190
WELL COMPLETION DATA: (1) diameter (inches) 4 in (2) total depth (feet) 190 (3) static water level (feet) 140 below top of ground (4) casing Plastic 190 (material) (depth) (size) If telescope see back. (5) screen 74 183 (length) (depth to top) 4 in Gravel (size) (material) (6) pump 1/2 10 (HP) (yield gpm) 110 (type power) (7) electric log No (yes or no) (organization running log) (8) how well bottom plugged Cap			
DRILLERS REMARKS:			


DEPT. OF NATURAL RESOURCES
BUREAU OF LAND & WATER RESOURCES

APR - 9 1980

RECEIVED

If well telescopes please
sketch and show depths.

GROUND LEVEL

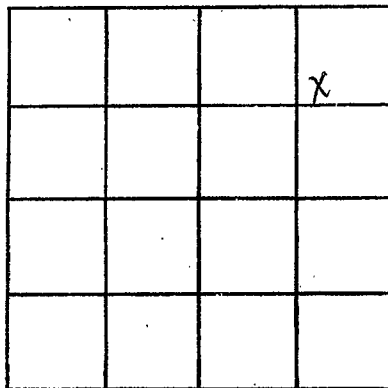

SECTION 30

Please indicate well location X.

ADDITIONAL INFORMATION

If more than one screen,
show locations of each on sketch.