

Marshall
 N 2033
 5-13-80

MISSISSIPPI
 BOARD OF WATER COMMISSIONERS
 416 North State Street
 Jackson, Mississippi 39201

WATER WELL DRILLERS LOG

4-28-80 date well completed 80 Nichols Well Co. firm name Marshall county well located

LANDOWNER:
 Bobby Deitman
 Rt. 3, Bohotia Miss
 (mailing address)

description of formations encountered	from	to
clay	0	30
red sand	30	120
white sand	120	170

WELL LOCATION:
 sec. 30 T-4 N R-4 E
 Mail right Rd.
 (distance) miles (direction) of (nearest town)

WELL PURPOSE: home
 (home, irrigation, municipal, industrial)

- WELL COMPLETION DATA:
- diameter (inches) 4 in
 - total depth (feet) 170
 - static water level (feet) 120 below top of ground.
 - casing Plastic 170 (material) (depth)
 - screen 7 ft 163 (length) (depth to top)
 4 in gravel (size) (material)
 - pump 1/2 HP 10 (yield gpm)
 220 (type power)
 - electric log No (yes or no)

(organization running log)
 (8) how well bottom plugged Cap

DEPT. OF NATURAL RESOURCES
 BUREAU OF LAND & WATER RESOURCES


MAY 12 1980

DRILLERS REMARKS:

RECEIVED

If well telescopes please
sketch and show depths.

GROUND LEVEL

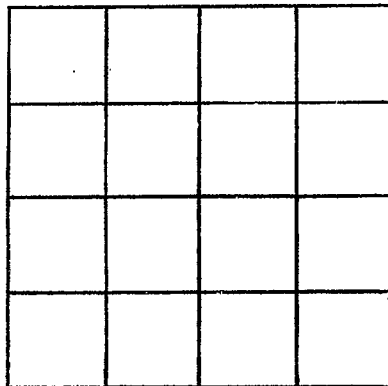

SECTION _____

Please indicate well location X.

ADDITIONAL INFORMATION

If more than one screen,
show locations of each on sketch.