

Marshall

N 2034

6-20-80

MISSISSIPPI BOARD OF WATER COMMISSIONERS
416 North State Street
Jackson, Mississippi 39201

WATER WELL DRILLERS LOG

June 20 19 80
date well completed

Earl Jones Well Co
firm name

Marshall
county well located

LANDOWNER:	description of formations encountered	from	to
Stacy Coleman			
Byholia miss - RT - (mailing address)	topsoil + clay sand	0 14	14 30
WELL LOCATION: sec 3 T 4 R 4 E 5 1/2 miles S of Victoria	clay sand	30 33	33 100
(distance) (direction) (nearest town)	clay sand	100 115	115 170
WELL PURPOSE: (home, irrigation, municipal, industrial)			
WELL COMPLETION DATA:			
(1) diameter (inches) 4"			
(2) total depth (feet) 170			
(3) static water level (feet) 125 below top of ground.			
(4) casing plastic 160 (material) (depth)			
4" (size) if telescope see back.			
(5) screen 10' 160 (length) (depth to top)			
0.13 plastic (size) (material)			
(6) pump 1/2 12 (HP) (yield gpm)			
electric (type power)			
(7) electric log no (yes or no)			
(organization running log)			
(8) how well bottom plugged plastic cap			
DRILLERS REMARKS:			


DEPT. OF NATURAL RESOURCES
BUREAU OF LAND & WATER RESOURCES

JUL 23 1980

RECEIVED

If well telescopes please sketch and show depths.

GROUND LEVEL

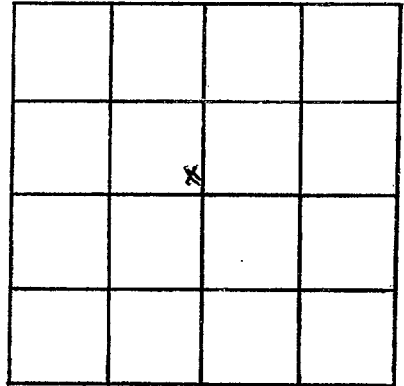

SECTION 3

Please indicate well location X.

ADDITIONAL INFORMATION

If more than one screen,
show locations of each on sketch.