

MARSHALL

N 2036

4-30-80

MISSISSIPPI BOARD OF WATER COMMISSIONERS 416 North State Street Jackson, Mississippi 39201

WATER WELL DRILLERS LOG

4/30/80 date well completed

BOB SMITH WELDER firm name

MARSHALL county well located

LANDOWNER

description of formations encountered

from to

Gene Jackson (mailing address) Marianna, Ms.

top soil 0 5
red clay 5 60
blue clay 60 140
sand 140 170

WELL LOCATION:

sec 27 T 4 N R 4 E S W of MARIANNA, MS (distance) (direction) (nearest town)

WELL PURPOSE:

(home, irrigation, municipal, industrial)

WELL COMPLETION DATA:

- (1) diameter (inches) 4"
(2) total depth (feet) 170'
(3) static water level (feet) 90' below top of ground
(4) casing plastic 170' (material) (depth)
(5) screen 10' 170' (length) (depth to top) 1/2" plastic (size) (material)
(6) pump 1/2 7 (HP) (yield gpm)
(7) electric log (yes or no)

DEPT. OF NATURAL RESOURCES BUREAU OF LAND & WATER RESOURCES

OCT 15 1980

RECEIVED


(organization running log)

(8) how well bottom plugged cap

DRILLERS REMARKS:

If well telescopes please sketch and show depths.

GROUND LEVEL

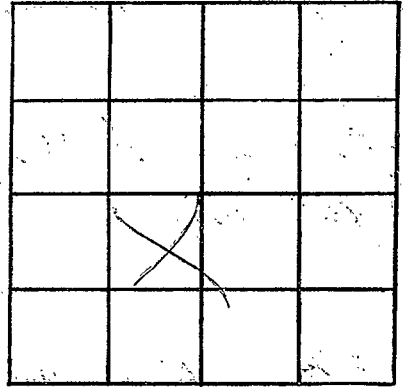

SECTION _____

Please indicate well location X.

ADDITIONAL INFORMATION

If more than one screen,
show locations of each on sketch.