

MARSHALL

N 2037

12-23-80

MISSISSIPPI  
 BOARD OF WATER COMMISSIONERS  
 416 North State Street  
 Jackson, Mississippi 39201

WATER WELL DRILLERS LOG

Dec 23 1980  
date well completed

Earl Jones Well Co  
firm name

Marshall  
county well located

LANDOWNER:

Hugh Mc Clatchy

Red Banks Missis

(mailing address)

WELL LOCATION:

sect 2 T 4 N R 4 E  
 5 1/2 miles S of Red Banks  
 (distance) (direction) (nearest town)

WELL PURPOSE: Home  
 (home, irrigation, municipal, industrial)

WELL COMPLETION DATA:

- (1) diameter (inches) 4"
- (2) total depth (feet) 132
- (3) static water level (feet) 65 below above top of ground.
- (4) casing plastic 122  
 (material) (depth)  
4" if telescope see back.  
 (size)
- (5) screen 10' 122  
 (length) (depth to top)  
4" - 013 plastic  
 (size) (material)
- (6) pump 1 20  
 (HP) (yield gpm)  
electric  
 (type power)
- (7) electric log No  
 (yes or no)

(organization running log)

(8) how well bottom plugged  
plastic cap

DRILLERS REMARKS:

description of formations encountered

from to


Topsail & clay	0	16
sand	16	30
clay	30	65
sand	65	90
clay	90	99
Rock	99	132

DEPT. OF NATURAL RESOURCES  
 BUREAU OF LAND & WATER RESOURCES

JAN 26 1981  
 RECEIVED

If well telescopes please sketch and show depths.

GROUND LEVEL

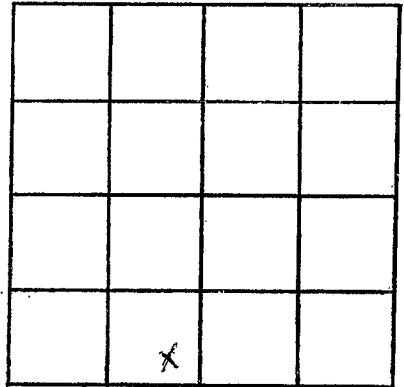

SECTION 12

Please indicate well location X.

ADDITIONAL INFORMATION

If more than one screen, show locations of each on sketch.