

MISSISSIPPI DEPARTMENT OF NATURAL RESOURCES

Bureau of Land and Water Resources

Southport Mall

P.O. Box 10631

Jackson, Mississippi 39209

WATER WELL DRILLERS LOG

MARSHALL  
N 2038  
10-12-81

10-12-81 19 Wilson Well Co Marshall  
date well completed firm name county well located

LANDOWNER: Archie Richmond  
RT 4 Bx 59A  
Byhalia, Miss 38611  
(mailing address)

description of formations encountered	from	to
<u>Red clay - Red sand</u>	<u>0</u>	<u>30</u>
<u>Red sand</u>	<u>30</u>	<u>60</u>
<u>Red sand white clay</u>	<u>60</u>	<u>90</u>
<u>White sand</u>	<u>90</u>	<u>150</u>

WELL LOCATION:  
sec. 3 T. 74 N R. 4 E  
5 miles S of Victoria  
(distance) (direction) (nearest town)

WELL PURPOSE: Home  
(home, irrigation, municipal, industrial)

- WELL COMPLETION DATA:
- (1) diameter (inches) 4
  - (2) total depth (feet) 145
  - (3) static water level (feet) 90 below above top of ground.
  - (4) casing Plastic (material), (depth)  
4 if telescope see back. (size)
  - (5) screen 10 (length), (depth to top)  
4 (size) (material)
  - (6) pump 3/4 (HP), 8 (yield gpm)  
Electric (type power)
  - (7) electric log NO (yes or no)

(organization running log)


(8) how well bottom plugged Plastic Cap

DRILLERS REMARKS: \_\_\_\_\_

DEPT. OF NATURAL RESOURCES  
BUREAU OF LAND & WATER RESOURCES  
OCT 27 1981  
RECEIVED

If well telescopes please sketch and show depths.

GROUND LEVEL

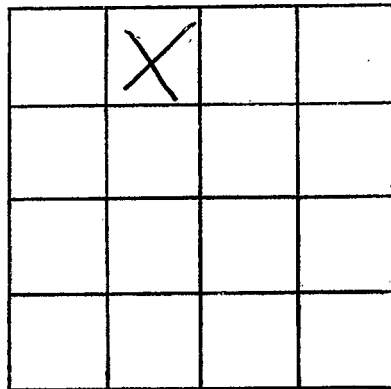

SECTION 3

Please indicate well location X.

ADDITIONAL INFORMATION

If more than one screen,  
show locations of each on sketch.