

MISSISSIPPI DEPARTMENT OF NATURAL RESOURCES

Bureau of Land and Water Resources

Southport Mall

P.O. Box 10631

Jackson, Mississippi 39209

WATER WELL DRILLERS LOG

**MARSHALL**  
 N 239  
 10-22-81

6

~~10-11-22~~ 10-22-81 date well completed  
 RT 1 BOX 177 firm name  
 SENATORIA MISS. county well located  
 Marshall

LANDOWNER: <u>Lee DeWalt</u>	description of formations encountered	from	to
<u>Res. 3</u>			
<u>Holly Springs, Ms.</u> (mailing address) <u>38635</u>	<u>Red Clay</u>	<u>0</u>	<u>15</u>
WELL LOCATION: sec. <u>30</u> T. <u>4</u> N. R. <u>4</u> E. <u>3</u> miles <u>NW</u> of <u>Chula</u> (distance) (direction) (nearest town)	<u>Red Sand</u>	<u>15</u>	<u>50</u>
WELL PURPOSE: <u>Home</u> (home, irrigation, municipal, industrial)	<u>Red Sand + White Clay</u>	<u>50</u>	<u>170</u>
WELL COMPLETION DATA: (1) diameter (inches) <u>4</u> (2) total depth (feet) <u>195</u> (3) static water level (feet) <u>140</u> below above top of ground. (4) casing <u>PVC</u> , <u>195</u> (material) (depth) <u>—</u> if telescope see back. (5) screen <u>12</u> , <u>183</u> (length) (depth to top) <u>4"</u> , <u>gravel + PVC</u> (size) (material) (6) pump <u>3/4</u> , <u>10</u> (HP) (yield gpm) <u>220V</u> (type power) (7) electric log <u>No</u> (yes or no) <u>—</u> (organization running log) (8) how well bottom plugged <u>Cap</u>	<u>White Sand</u>	<u>170</u>	<u>195</u>
DRILLERS REMARKS:			


DEPT. OF NATURAL RESOURCES  
 BUREAU OF LAND & WATER RESOURCES

NOV 9 1981  
 NOV 9 1981

RECEIVED

If well telescopes please sketch and show depths.

GROUND LEVEL

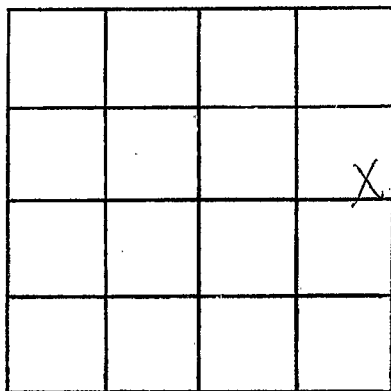

SECTION 30

Please indicate well location X.

ADDITIONAL INFORMATION

If more than one screen,  
show locations of each on sketch.