

MISSISSIPPI DEPARTMENT OF NATURAL RESOURCES

Bureau of Land and Water Resources

Southport Mall

P.O. Box 10631

Jackson, Mississippi 39209

WATER WELL DRILLERS LOG

<u>Marshall</u>
<u>N</u>
<u>2041</u>

date well completed 7-9 19 82

HICKS WELL CO.

Rt. 1, Box 15/
Hicksville, MS 38669Marshall
county well locatedLANDOWNER James Bowmandescription of formations
encountered

from

to

Rt. 3Red Clay0 20Holly Springs, Miss.
(mailing address) 38635Red + White Clay20 65

WELL LOCATION:

sec. 27 T 4 N R 4 E
3/4 miles S of Marshall
(distance) (direction) (nearest town)White Sand65 160B. Jack Clay160 190WELL PURPOSE: Home
(home, irrigation, municipal, industrial)White Sand190 215

WELL COMPLETION DATA:

- (1) diameter (inches) 4
- (2) total depth (feet) 215
- (3) static water level (feet) 120 below above
top of ground.
- (4) casing PVC, 215
(material) (depth)
- 4"
(size) If telescope see back.
- (5) screen 2', 208'
(length) (depth to top)
- .02, gravel + PVC
(size) (material)
- (6) pump 1/2, 10
(HP) (yield gpm)
- 220V
(type power)
- (7) electric log no
(yes or no)

(organization running log)


(8) how well bottom plugged Cap

DRILLERS REMARKS:

DEPT. OF NATURAL RESOURCES
BUREAU OF LAND & WATER RESOURCESAUG - 4 1982
RECEIVED

If well telescopes please
sketch and show depths.

GROUND LEVEL

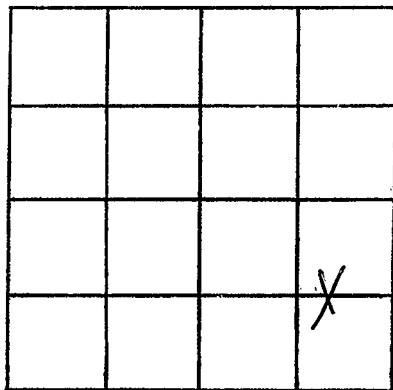

SECTION 27

Please indicate well location X.

ADDITIONAL INFORMATION

If more than one screen,
show locations of each on sketch.