

MISSISSIPPI DEPARTMENT OF NATURAL RESOURCES

Bureau of Land and Water Resources

Southport Mall

P.O. Box 10631

Jackson, Mississippi 39209

WATER WELL DRILLERS LOG

Marshall  
N  
2042

8-6-81 19 Bob Smith  
 date well completed firm name

Marshall  
 county well located

LANDOWNER:

Thomas Williams  
Marianna, Mo.  
 (mailing address)

description of formations encountered

from to

<u>Top Soil</u>	<u>0</u>	<u>5</u>
<u>red clay</u>	<u>5</u>	<u>35'</u>
<u>gravel</u>	<u>35</u>	<u>70</u>
<u>whitesand</u>	<u>70</u>	<u>180</u>

WELL LOCATION:

sec 20 T 4 N R 4 E  
 (distance) miles 3 (direction) W of MARIANNA  
 (nearest town)

WELL PURPOSE:

(home, irrigation, municipal, industrial)

WELL COMPLETION DATA:

- (1) diameter (inches) 4"
- (2) total depth (feet) 180'
- (3) static water level (feet) 140' below above top of ground.
- (4) casing plastic 180'  
 (material) (depth)

\_\_\_\_\_ If telescope see back.  
 (size)

- (5) screen 20' 160'  
 (length) (depth to top)
- 4" plastic  
 (size) (material)

- (6) pump 1/2 10  
 (HP) (yield gpm)
- elec.  
 (type power)

- (7) electric log (yes of no)

\_\_\_\_\_ (organization running log)

- (8) how well bottom plugged Cap

DRILLERS REMARKS:


DEPT. OF NATURAL RESOURCES  
 BUREAU OF LAND & WATER RESOURCES

OCT 12 1981

RECEIVED

If well telescopes please sketch and show depths.

GROUND LEVEL

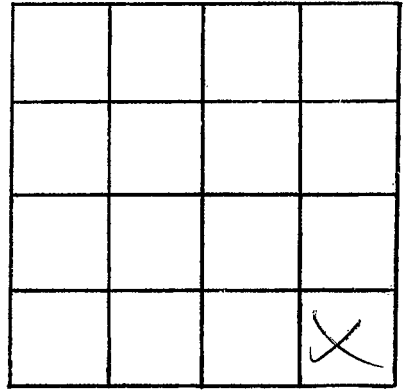

SECTION \_\_\_\_\_

Please indicate well location X.

ADDITIONAL INFORMATION

If more than one screen,  
show locations of each on sketch.