

MISSISSIPPI DEPARTMENT OF NATURAL RESOURCES
Bureau of Land and Water Resources
 Southport Mall
 P.O. Box 10631
 Jackson, Mississippi 39209
WATER WELL DRILLERS LOG

Marshall
N
2043

date well completed 11-29 1982 HICKS WELL CO. county well located Marshall
Rt. 1, Box 1546 Senatobia, MS 38660

LANDOWNER: <u>James Harris</u>	description of formations encountered	from	to
<u>Rt. 3</u>			
<u>Holly Springs, Ms.</u> <small>(mailing address) 38635</small>	<u>Red Clay</u>	<u>0</u>	<u>20</u>
WELL LOCATION:	<u>Red Sand</u>	<u>20</u>	<u>35</u>
sec. <u>26</u> T. <u>4</u> N. <u>5</u> R. <u>4</u> E. <u>W</u>	<u>White Sand</u>	<u>35</u>	<u>110</u>
<u>1</u> miles <u>S</u> of <u>Marion</u>	<u>Black Clay + White Clay</u>	<u>110</u>	<u>155</u>
<small>(distance) (direction) (nearest town)</small>	<u>White sand + clay</u>	<u>155</u>	<u>180</u>
WELL PURPOSE: <u>Home</u> <small>(home, irrigation, municipal, industrial)</small>	<u>White Sand</u>	<u>180</u>	<u>205</u>
WELL COMPLETION DATA:			
(1) diameter (inches) <u>4</u>			
(2) total depth (feet) <u>205</u>			
(3) static water level (feet) _____ below/above top of ground.			
(4) casing <u>PVC</u> , <u>205</u> , <small>(material) (depth)</small>			
<u>4"</u> <small>(size) if telescope see back.</small>			
(5) screen <u>10</u> , <u>195</u> <small>(length) (depth to top)</small>			
<u>1/2"</u> , <u>PVC</u> <small>(size) (material)</small>			
(6) pump <u>1/2</u> , <u>10</u> <small>(HP) (yield gpm)</small>			
<u>220V</u> <small>(type power)</small>			
(7) electric log <u>No</u> <small>(yes or no)</small>			
_____ <small>(organization running log)</small>			
(8) how well bottom plugged <u>Cap</u>			

DEPT. OF NATURAL RESOURCES
 BUREAU OF LAND & WATER RESOURCES


DEC - 8 1982

DRILLERS REMARKS:

RECEIVED

If well telescopes please sketch and show depths.

GROUND LEVEL

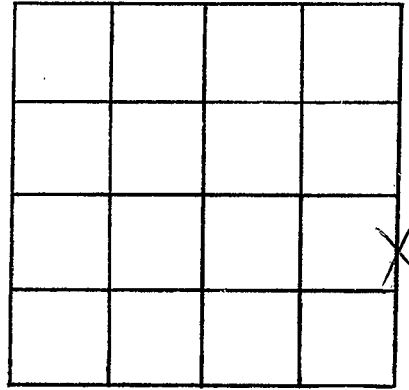

SECTION 26

Please indicate well location X.

ADDITIONAL INFORMATION

If more than one screen,
show locations of each on sketch.