

MISSISSIPPI DEPARTMENT OF NATURAL RESOURCES

Bureau of Land and Water Resources

Southport Mall

P.O. Box 10631

Jackson, Mississippi 39209

WATER WELL DRILLERS LOG

NICKS WELL CO.

Marshall
N
2045

6-15 1983
date well completed

firm name

Marshall
county well located

LANDOWNER: J. T. Blackman
Rt. 5 Box 196
Holly Springs, Miss.
(mailing address) 38635

description of formations encountered	from	to
<u>Red Sand & Clay</u>	<u>0</u>	<u>95</u>
<u>White Sand</u>	<u>95</u>	<u>145</u>

WELL LOCATION:
sec 29 T 4 N R 4 E
2 1/2 miles W of Marion
(distance) (direction) (nearest town)

WELL PURPOSE: Home
(home, irrigation, municipal, industrial)

WELL COMPLETION DATA:

- (1) diameter (inches) 4
- (2) total depth (feet) 145
- (3) static water level (feet) 80 ^{below}/_{above} top of ground.
- (4) casing PVC, 145
(material) (depth)
4" if telescope see back.
(size)
- (5) screen 10', 135
(length) (depth to top)
.013, PVC
(size) (material)
- (6) pump 1/2, 10
(HP) (yield gpm)
220V
(type power)
- (7) electric log No
(yes or no)
- (organization running log)
- (8) how well bottom plugged Caps

DRILLERS REMARKS:


DEPT. OF NATURAL RESOURCES
BUREAU OF LAND & WATER RESOURCES

JUN 27 1983

RECEIVED

If well telescopes please sketch and show depths.

GROUND LEVEL

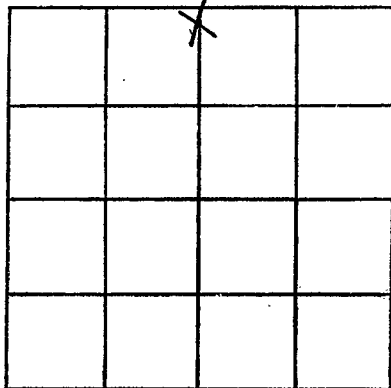

SECTION 29

Please indicate well location X.

ADDITIONAL INFORMATION

If more than one screen
show locations of each on sketch.