

MISSISSIPPI DEPARTMENT OF NATURAL RESOURCES

Bureau of Land and Water Resources

Southport Mall

P.O. Box 10631

Jackson, Mississippi 39209

WATER WELL DRILLERS LOG

HICKS WELL CO.  
Rt. 1, Box 157  
Spartanburg, Miss 39068

Marshall  
N  
2046

Marshall  
county well located

7-19 1983  
date well completed

LANDOWNER: James Turner  
Rt. 3

description of formations encountered

from

to

Holly Springs, Mo.  
(mailing address) 38635

Red Clay

0

20

WELL LOCATION:  
sec. 19 T 4 N R 4 E  
1 miles SE of Mathis Cross  
(distance) (direction) (nearest town)

Red Sand

20

50

White Sand + Clay

50

140

White Sand

140

168

WELL PURPOSE: Home  
(home, irrigation, municipal, industrial)

WELL COMPLETION DATA:

(1) diameter (inches) 4

(2) total depth (feet) 168

(3) static water level (feet) 100 <sup>below</sup>/<sub>above</sub> top of ground.

(4) casing PVC 168  
(material) (depth)

4'  
(size) if telescope see back.

(5) screen 10' 158'  
(length) (depth to top)

013 PVC  
(size) (material)

(6) pump 1/2 10  
(HP) (yield gpm)

220V  
(type power)

(7) electric log No  
(yes or no)

(organization running log)

(8) how well bottom plugged Cap

DRILLERS REMARKS:


DEPT. OF NATURAL RESOURCES  
BUREAU OF LAND & WATER RESOURCES

AUG 11 1983

RECEIVED

If well telescopes please sketch and show depths.

GROUND LEVEL

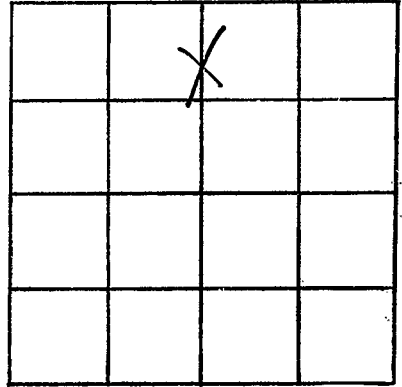

SECTION 19

Please indicate well location X.

ADDITIONAL INFORMATION

If more than one screen,  
show locations of each on sketch.