

MISSISSIPPI DEPARTMENT OF NATURAL RESOURCES

Bureau of Land and Water Resources

Southport Mall

P.O. Box 10631

Jackson, Mississippi 39209

WATER WELL DRILLERS LOG

HICKS WELL CO.
Rt. 1, Box 157

Marshall
N
2047

7-25 1983

Marshall
county well located

date well completed

film name

LANDOWNER: Clyde South
Rt. 3
Holly Springs, Ms.
(mailing address) 38635

description of formations encountered	from	to
Red clay	0	20
Red sand	20	40
White Sand + clay	40	80
White Sand	80	190

WELL LOCATION:
sec 20 T. 4 N. R. 4 E.
3 miles W of Manassas
(distance) (direction) (nearest town)

WELL PURPOSE: Home
(home, irrigation, municipal, industrial)

WELL COMPLETION DATA:

- (1) diameter (inches) 4
- (2) total depth (feet) 190'
- (3) static water level (feet) 100' below top of ground
- (4) casing (material) PVC (depth) 190'
(size) 4" if telescope see back.
- (5) screen (length) 10 (depth to top) 180'
(size) 2 1/2" (material) PVC
- (6) pump (HP) 1/2 (yield gpm) 10
(type power) 220V
- (7) electric log No (yes or no)
(organization running log)
- (8) how well bottom plugged Cap

DRILLERS REMARKS:


DEPT. OF NATURAL RESOURCES
BUREAU OF LAND & WATER RESOURCES

AUG 15 1983

RECEIVED

If well telescopes please sketch and show depths.

GROUND LEVEL

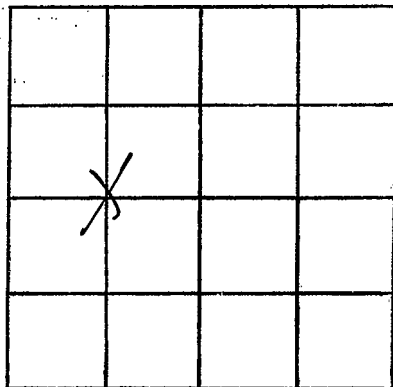

SECTION 20

Please indicate well location X.

ADDITIONAL INFORMATION

If more than one screen, show locations of each on sketch.