

MISSISSIPPI DEPARTMENT OF NATURAL RESOURCES

Bureau of Land and Water Resources

Southport Mall

P.O. Box 10631

Jackson, Mississippi 39209

WATER WELL DRILLERS LOG

Marshall
N
248

date well completed 2/27/84 firm name Bullett well county well located Marshall

LANDOWNER: <u>H. H. Hawks</u>	description of formations encountered	from	to
<u>Mossburn</u>	<u>top soil</u>	<u>0</u>	<u>17</u>
(mailing address)	<u>white clay</u>	<u>18</u>	<u>25</u>
WELL LOCATION: sec. <u>9</u> T. <u>4</u> N. R. <u>4</u> E. (distance) (direction) (nearest town) <u>Mossburn</u> miles <u>North</u> of <u>Mossburn</u>	<u>white sand</u>	<u>25</u>	<u>50</u>
WELL PURPOSE: (home, irrigation, municipal, industrial)			
WELL COMPLETION DATA: (1) diameter (inches) <u>4</u> (2) total depth (feet) <u>60</u> (3) static water level (feet) <u>5'</u> above top of ground. (4) casing <u>4"</u> (material) <u>PVC</u> (depth) <u>60</u> (size) if telescope see back. (5) screen <u>10</u> (length) <u>50</u> (depth to top) <u>4"</u> (size) (material) (6) pump <u>1/2</u> (HP) <u>10</u> (yield gpm) <u>Motor</u> (type power) (7) electric log <u>no</u> (yes or no) (organization running log) (8) how well bottom plugged <u>Cap</u>			
DRILLERS REMARKS:			


DEPT. OF NATURAL RESOURCES
 BUREAU OF LAND & WATER RESOURCES

APR 26 1984

RECEIVED

If well telescopes please sketch and show depths.

GROUND LEVEL

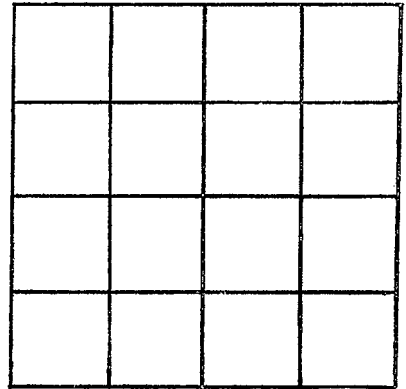

SECTION _____

Please indicate well location X.

ADDITIONAL INFORMATION

If more than one screen,
show locations of each on sketch.