

MISSISSIPPI DEPARTMENT OF NATURAL RESOURCES

Bureau of Land and Water Resources

Southport Mall

P.O. Box 10631

Jackson, Mississippi 39209

WATER WELL DRILLERS LOG

HICKS WELL CO.

Rt. 1, Box 157

Genatobia, MS 38668

county well located

*Marshall*

MARSHALL  
N 2049

7/2 1984  
date well completed

LANDOWNER: *Roger Echols*  
*Rt. 3 Box 113*  
*Holly Springs, Ms. 38835*  
(mailing address)

description of formations encountered	from	to
<i>Red Clay</i>	<i>0</i>	<i>20</i>
<i>Red Sand</i>	<i>20</i>	<i>82</i>
<i>white Sand</i>	<i>80</i>	<i>155</i>

WELL LOCATION:  
sec. *29* T. *4* N. R. *4* E  
*2 1/2* miles *W* of *Marion*  
(distance) (direction) (nearest town)

WELL PURPOSE: *Home*  
(home, irrigation, municipal, industrial)

- WELL COMPLETION DATA:
- (1) diameter (inches) *4*
  - (2) total depth (feet) *155*
  - (3) static water level (feet) *80* *below* above top of ground.
  - (4) casing *PVC*, *155*  
(material) (depth)  
*4"*  
(size) if telescope see back.
  - (5) screen *10'*, *145'*  
(length) (depth to top)  
*1010*, *PVC*  
(size) (material)
  - (6) pump *1/2*, *10*  
(HP) (yield gpm)  
*220V*  
(type power)
  - (7) electric log *No*  
(yes or no)  
(organization running log)

(8) how well bottom plugged *Cap*


DRILLERS REMARKS:

DEPT. OF NATURAL RESOURCES  
BUREAU OF LAND & WATER RESOURCES

RECEIVED  
JUL 10 1984

If well telescopes please sketch and show depths.

GROUND LEVEL

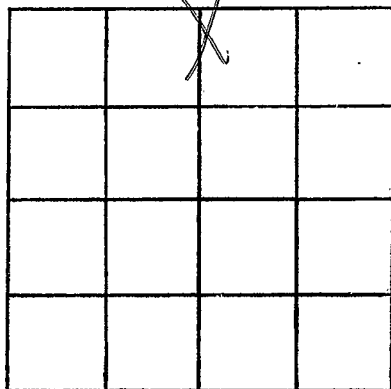

SECTION 29

Please indicate well location X.

ADDITIONAL INFORMATION

If more than one screen,  
show locations of each on sketch.