

MISSISSIPPI DEPARTMENT OF NATURAL RESOURCES

Bureau of Land and Water Resources

Southport Mall

P.O. Box 10631

Jackson, Mississippi 39209

WATER WELL DRILLERS LOG

Marshall  
N  
2050

7/25/84 19 Sullitt well drilling Marshall  
 date well completed firm name county well located

LANDOWNER: David Harris  
 (mailing address)

WELL LOCATION:  
 sec. 14 T. 4 (N) R. 4 E  
10 miles West of Hollis  
 (distance) (direction) (nearest town)

WELL PURPOSE: None  
 (home, irrigation, municipal, industrial)

- WELL COMPLETION DATA:
- (1) diameter (inches) 4
  - (2) total depth (feet) 190'
  - (3) static water level (feet) 150 below above top of ground.
  - (4) casing PVC, 180',  
 (material) (depth)  
4 if telescope see back.  
 (size)
  - (5) screen 10, 180'  
 (length) (depth to top)  
4, PVC  
 (size) (material)
  - (6) pump 1/2, 5  
 (HP) (yield gpm)  
Elect  
 (type power)
  - (7) electric log No  
 (yes or no)  
No  
 (organization running log)
  - (8) how well bottom plugged yes

description of formations encountered	from	to
<u>red clay</u>	<u>0</u>	<u>20</u>
<u>red sand</u>	<u>20'</u>	<u>60</u>
<u>ord clay</u>		
<u>white sand</u>		
<u>ord clay</u>	<u>60</u>	<u>150</u>
<u>white sand</u>	<u>150</u>	<u>190</u>

DRILLERS REMARKS:


DEPT. OF NATURAL RESOURCES  
 BUREAU OF LAND & WATER RESOURCES

AUG 2 1984

RECEIVED

If well telescopes please sketch and show depths.

GROUND LEVEL

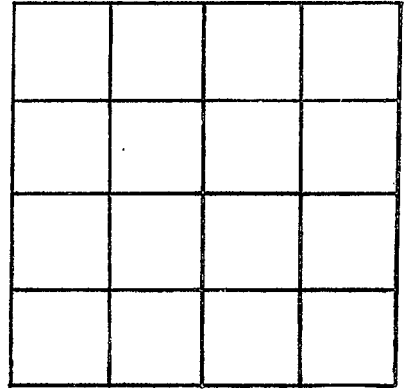

SECTION \_\_\_\_\_

Please indicate well location X.

ADDITIONAL INFORMATION

If more than one screen, show locations of each on sketch.