

MISSISSIPPI DEPARTMENT OF NATURAL RESOURCES

Bureau of Land and Water Resources

Southport Mall

P.O. Box 10631

Jackson, Mississippi 39209

WATER WELL DRILLERS LOG

Marshall
N 251
6-6-85

~~HICKS WELL COMPANY~~

~~HICKS WELL CO.~~
~~SENATOBIA, MISS.~~

6-6-1985
 date well completed

Marshall
 county well located

LANDOWNER: Bernitta Jones

description of formations encountered

from to

Rt #3

Holly Springs 38835
 (mailing address)

Red clay	0	20
Red Sand	20	50
White Sand & clay	50	80
Black & white clay	80	140
White sand	140	185

WELL LOCATION:

sec. 27 T. 4 N. R. 4 E.
 (S) (W)
1 miles South of Marion
 (distance) (direction) (nearest town)

WELL PURPOSE: Home
 (home, irrigation, municipal, industrial)

WELL COMPLETION DATA:


- (1) diameter (inches) 4"
- (2) total depth (feet) 185'
- (3) static water level (feet) 140' ^{below} _{above} top of ground.
- (4) casing PVC, 175'
 (material) (depth)
4"
 (size) if telescope see back.
- (5) screen 10', 175'
 (length) (depth to top)
.010, PVC
 (size) (material)
- (6) pump 3/4, 10
 (HP) (yield gpm)
220 Electric
 (type power)
- (7) electric log NO
 (yes or no)
 (organization running log)
- (8) how well bottom plugged Cap

RECEIVED
 JUL 1 1985

DRILLERS REMARKS:

If well telescopes please sketch and show depths.

GROUND LEVEL

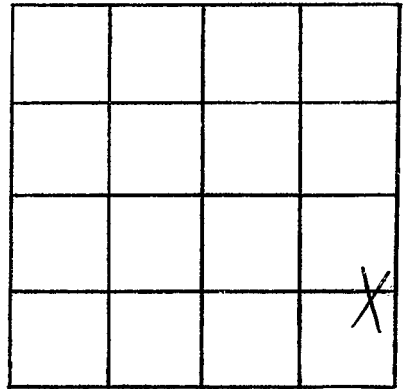

SECTION 27

Please indicate well location X.

ADDITIONAL INFORMATION

If more than one screen,
show locations of each on sketch.