

MISSISSIPPI DEPARTMENT OF NATURAL RESOURCES

Bureau of Land and Water Resources

Southport Mall

P.O. Box 10631

Jackson, Mississippi 39209

WATER WELL DRILLERS LOG

Newsome
N 2053

5-12 19*86* *Larry Carpenter Well Co.* *Marshall*
 date well completed firm name county well located

LANDOWNER *Walter Jenkins*
Holly Springs,
Ms. RFD
 (mailing address)

description of formations encountered	from	to
<i>Surface Soil</i>	<i>0</i>	<i>19</i>
<i>Coarse Red Sand</i>	<i>19</i>	<i>30</i>
<i>Med. White Sand</i>	<i>30</i>	<i>45</i>
<i>White Clay</i>	<i>45</i>	<i>68</i>
<i>Med. White Sand</i>	<i>68</i>	<i>85</i>
<i>White coarse sand</i>	<i>85</i>	<i>125</i>

WELL LOCATION:
 sec. *21* T *4* N R *4* E
 S W
3 miles *S. East* of *H.S.*
 (distance) (direction) (nearest town)


WELL PURPOSE: *Home*
 (home, irrigation, municipal, industrial)

WELL COMPLETION DATA:

- (1) diameter (inches) *4*
- (2) total depth (feet) *125*
- (3) static water level (feet) *78* below above top of ground.
- (4) casing *PVC*, *115'*
 (material) (depth)
 (size) if telescope see back.
- (5) screen *10'*, *115'*
 (length) (depth to top)
4", *PVC*
 (size) (material)
- (6) pump *1/2*, *10*
 (HP) (yield gpm)
Elec
 (type power)
- (7) electric log *no*
 (yes or no)

(organization running log)

(8) how well bottom plugged *PVC cap*

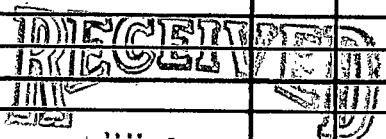


JUL 23 1986

Department of Natural Resources
 Bureau of Land & Water Resources

DRILLERS REMARKS:

If well telescopes please sketch and show depths.

GROUND LEVEL

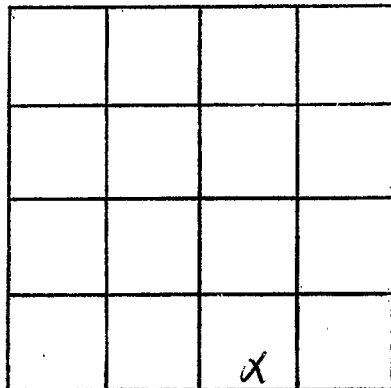

SECTION 21

Please indicate well location X.

ADDITIONAL INFORMATION

If more than one screen, show locations of each on sketch.