

MISSISSIPPI DEPARTMENT OF NATURAL RESOURCES

Bureau of Land and Water Resources

COUNTY WELL LOCATED	
<i>Marshall</i>	
WELL NUMBER	CODED
<i>N 2066</i>	
DATE WELL COMPLETED	
<i>7-16-90</i>	

PERMIT NUMBER
HICKS WELL CO.
NAME OF DRILLING FIRM
RT. 1 BOX 157
SENATOBIA, MS 38668

P.O. Box 10631
Jackson, Mississippi 39209
WATER WELL DRILLERS LOG

NAME & MAILING ADDRESS OF LANDOWNER		
<i>Sidney Semms</i>		
<i>RT. 3</i>		
<i>Holly Springs, Ms. 38635</i>		
WELL LOCATION: SEC	TOWNSHIP	RANGE
<i>26</i>	<i>4</i>	<i>N 4 E</i>
DISTANCE	DIRECTION	NEAREST TOWN
<i>10</i> Miles	<i>W</i>	<i>Holly Sp.</i>
OTHER LANDMARK		
<i>Marion</i>		
WELL PURPOSE (Home Irrigation, Municipal, Industrial, Fish Pond, etc.)		

PUMP DATA		
PUMP TYPE (Circle One):		
<input checked="" type="radio"/> Submersible Turbine Jet Flowing Well,		
Other (Describe) _____		
POWER TYPE (Circle One):		
Electric, Tractor, Diesel, Gasoline, Butane,		
Other (Describe) _____		
Pump Capacity (GPM)	No. of Stages	Setting Depth
<i>10</i>	<i>12</i>	<i>160</i> FT.
PUMP TEST		
Well yielded _____ <i>10</i> GPM with		
a drawdown of _____ ft.		
after _____ hours of pumping		

WELL DATA		
Well Depth	Casing Diameter (In.)	Casing Length (Ft.)
<i>180</i>	<i>4"</i>	<i>170</i>
Type of Casing	Hole Depth	Depth to Static Water Level
<i>PVC</i>	<i>180</i>	<i>130</i>
TYPE OF COMPLETION: (Circle One or More):		
<input checked="" type="checkbox"/> Gravel Packed Underreamed Telescoped,		
Natural Development, Open Hole, Other		
(Describe) _____		
Top of Lap Pipe or Reduction in Casing		
FEET		IF TELESCOPED OR MORE THAN ONE SCREEN: USE BACK PAGE

LOG DATA	
TYPE OF LOG RUN (Circle One):	
<input type="radio"/> No Log Run, Electric, Gamma Ray, Density, Sonic, Neutron,	
Other (Describe) _____	
Name of Organization Running Log	


SCREEN DATA		
Diameter - Inches	Length - Feet	Slot Size - Inches
<i>4"</i>	<i>10'</i>	<i>0.13</i>
Screen Type	Depth to Bottom - Feet	
<i>PVC</i>	<i>10'</i>	

GEOLOGIC DATA (Office Use Only)			
Surface Elev.	Geologic Unit	Unit Thickness	Depth to Top
Subs. SWL	Date	Analysis	Aquifer Test
Driller's Remarks			

DESCRIPTION OF FORMATIONS ENCOUNTERED	FROM	TO	FORMATIONS (Continued)	FROM	TO
<i>Red clay</i>	<i>0</i>	<i>10</i>	RECEIVED		
<i>RC & S</i>	<i>10</i>	<i>140</i>			
<i>US</i>	<i>140</i>	<i>180</i>			
			AUG 28 1990		
			Department of Natural Resources		
			Bureau of Land & Water Resources		
IF MORE SPACE IS NEEDED, USE BACK					

If well telescopes please sketch and show depths.

GROUND LEVEL

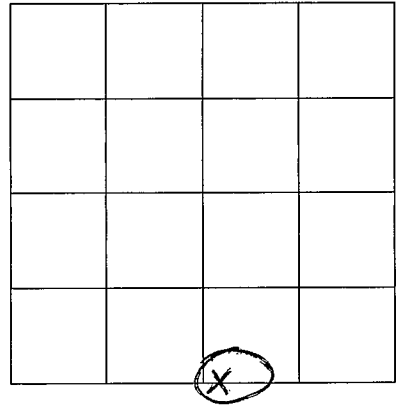

SECTION _____

Please indicate well location X.

ADDITIONAL INFORMATION

If more than one screen,
show location of each on sketch.