

# MISSISSIPPI DEPARTMENT OF NATURAL RESOURCES

Bureau of Land and Water Resources

COUNTY WELL LOCATED <b>MARSHAL</b>	
WELL NUMBER <b>N 2060</b>	CODED
DATE WELL COMPLETED <b>11-29-90</b>	

PERMIT NUMBER <b>HICKS WELL CO.</b>
NAME OF DRILLING FIRM <b>RT. 1 BOX 157 SENATOBIA, MS 38668</b>

P.O. Box 10631  
Jackson, Mississippi 39209  
WATER WELL DRILLERS LOG

NAME & MAILING ADDRESS OF LANDOWNER <b>MIKE TYLER VICTORIA MS.</b>			
WELL LOCATION:    SEC    TOWNSHIP    RANGE			
	<b>2</b>	<b>4 N</b>	<b>4 E</b>
DISTANCE                      DIRECTION                      NEAREST TOWN			
<b>4</b> Miles		<b>S/E</b> of <b>VICTORIA</b>	
OTHER LANDMARK			
WELL PURPOSE: <input checked="" type="checkbox"/> Home Irrigation, Municipal, Industrial, Fish Pond, etc.			

PUMP DATA			
PUMP TYPE (Circle One): <del>Submersible</del> Turbine,    Jet    Flowing Well, Other (Describe) _____			
POWER TYPE (Circle One): <del>Electric</del> Tractor, Diesel,    Gasoline,    Butane, Other (Describe) _____ H/P <input checked="" type="checkbox"/>			
Pump Capacity (GPM) <b>18</b>	No. of Stages <b>12</b>	Setting Depth <b>100</b> FT.	
PUMP TEST			
Well yielded _____ GPM with a drawdown of _____ ft. after _____ hours of pumping			

WELL DATA		
Well Depth <b>130</b>	Casing Diameter (In.) <b>4"</b>	Casing Length (Ft.) <b>120</b>
Type of Casing <b>PVC</b>	Hole Depth <b>130</b>	Depth to Static Water Level <b>60</b>
TYPE OF COMPLETION: (Circle One or More): <input checked="" type="checkbox"/> Gravel Packed, <input type="checkbox"/> Underreamed, <input type="checkbox"/> Telescoped, <input type="checkbox"/> Natural Development, <input type="checkbox"/> Open Hole, <input type="checkbox"/> Other (Describe) _____		
Top of Lap Pipe or Reduction in Casing		
FEET    IF TELESCOPED OR MORE THAN ONE SCREEN: USE BACK PAGE		

LOG DATA	
TYPE OF LOG RUN (Circle One):    No Log Run, Electric, Gamma Ray, Density, Sonic, Neutron, Other (Describe) _____	
Name of Organization Running Log	

SCREEN DATA		
Diameter - Inches <b>4"</b>	Length - Feet <b>10'</b>	Slot Size - Inches <b>013</b>
Screen Type <b>PVC</b>		Depth to Bottom - Feet <b>10'</b>


GEOLOGIC DATA (Office Use Only)			
Surface Elev.	Geologic Unit	Unit Thickness	Depth to Top
Subs. SWL	Date	Analysis	Aquifer Test
Driller's Remarks			

DESCRIPTION OF FORMATIONS ENCOUNTERED	FROM	TO	FORMATIONS (Continued)	FROM	TO
<b>AC</b>	<b>0</b>	<b>5</b>	<b>RECEIVED</b>  <b>JAN 30 1991</b>  Dept. of Environmental Quality Bureau of Land & Water Resources		
<b>WS-</b>	<b>5</b>	<b>130</b>			

IF MORE SPACE IS NEEDED, USE BACK

If well telescopes please  
sketch and show depths.

GROUND LEVEL

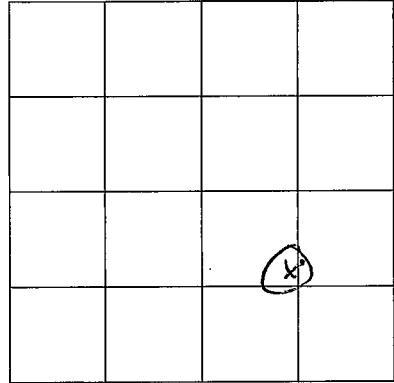

SECTION \_\_\_\_\_

Please indicate well location X.

ADDITIONAL INFORMATION

If more than one screen,  
show location of each on sketch.