

MISSISSIPPI DEPARTMENT OF NATURAL RESOURCES

Bureau of Land and Water Resources

Southport Mall

P.O. Box 10631

Jackson, Mississippi 39209

WATER WELL DRILLERS LOG

N 2074
 Marshall
 7-17-85

HICKS WELL COMPANY

Marshall

7-17-85
 date well completed

Rt. 1 firm name

county well located

LANDOWNER: Deloris Jones

P.O. Box 845

Holly Springs 38835
 (mailing address)

WELL LOCATION:

sec. 27 T 4 N R 4 E
 (3) (W)
 1 miles S of Maricopa
 (distance) (direction) (nearest town)

WELL PURPOSE: Home
 (home, irrigation, municipal, industrial)

WELL COMPLETION DATA:

- (1) diameter (inches) 4"
- (2) total depth (feet) 200'
- (3) static water level (feet) 180' below top of ground.
- (4) casing PVC, 190' (depth)
 4" (size) if telescope see back.
- (5) screen 10' (length), 190' (depth to top)
 0.13 (size), PVC (material)
- (6) pump 3/4 (HP), 10 (yield gpm)
 220 V (type power)
- (7) electric log NO (yes or no)
 (organization running log)
- (8) how well bottom plugged Cap

description of formations encountered

from to

Red Clay	0	10
Red Sand	10	50
White Clay	50	90
White Clay & Sand	90	150
White Sand	150	200


DRILLERS REMARKS:

RECEIVED
 OCT 17 1985

Department of Natural Resources
 Bureau of Land & Water

If well telescopes please sketch and show depths.

GROUND LEVEL

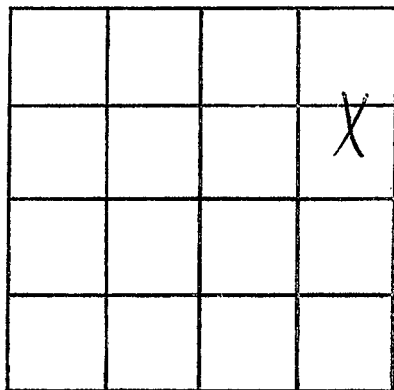

SECTION 27

Please indicate well location X.

ADDITIONAL INFORMATION

If more than one screen,
show locations of each on sketch.