

MARSHALL

0-1

3-30-71

MISSISSIPPI BOARD OF WATER COMMISSIONERS 416 North State Street Jackson, Mississippi 39201

CODED

WATER WELL DRILLERS LOG

Mar. 30 1971 date well completed

R. L. Carpenter firm name

Marshall county well located

LANDOWNER: Helen Richmond Red Banks, Miss RFD (mailing address)

description of formations encountered	from	to
Surface Soil	0	18
Coarse red Red sand	18	43
white sand	42	83
white clay	83	110
Coarse white sand	110	140

WELL LOCATION:

sec. 7 T. 4 N. R. 3 E. S. W. 5 miles South of Red Banks (distance) (direction) (nearest town)

WELL PURPOSE: Home (home, irrigation, municipal, industrial)

WELL COMPLETION DATA:

- (1) diameter (inches) 4 in
- (2) total depth (feet) 140
- (3) static water level (feet) 75 below top of ground.
- (4) casing Plastic, 134 ft (material) (depth) (size) If telescope see back.
- (5) screen 6 ft, 134 ft (length) (depth to top) 4 in Plastic & Bavel (size) (material)
- (6) pump 3/4 HP, 10 (HP) (yield gpm) Elec. (type power)
- (7) electric log no (yes or no)

(organization running log)

(8) how well bottom plugged Plastic Cap.


SEP 2 1971

DRILLERS REMARKS:

MISS. RD. OF WATER COMMISSIONERS

If well telescopes please sketch and show depths.

GROUND LEVEL

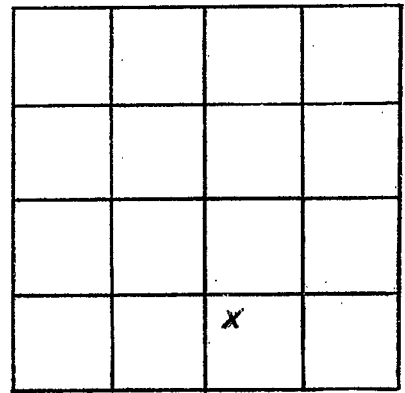

SECTION 2

Please indicate well location X.

ADDITIONAL INFORMATION

A series of horizontal lines for writing additional information, starting below the 'ADDITIONAL INFORMATION' header and extending to the bottom of the page.

If more than one screen, show locations of each on sketch.