

MARSHALL
03
7-14-72

MISSISSIPPI
 BOARD OF WATER COMMISSIONERS
 416 North State Street
 Jackson, Mississippi 39201

CODED

WATER WELL DRILLERS LOG

7-14-72 date well completed
 Pump & Sewer Co. firm name
 Marshall county well located

LANDOWNER:
 James E. Jones
 Rt 3, Nell Springs
 (mailing address)

| description of formations encountered | from | to |
|---------------------------------------|------|-----|
| clay | 0 | 20 |
| sand | 20 | 220 |

WELL LOCATION:
 sec. 4 T. 4 N. R. 3 E.
 6 miles S.W. of Nell Springs
 (distance) (direction) (nearest town)

WELL PURPOSE: Municipal
 (home, irrigation, municipal, industrial)

WELL COMPLETION DATA: 4"

- (1) diameter (inches) ~~3 1/2~~
- (2) total depth (feet) 220 feet
- (3) static water level (feet) 170 below top of ground.
- (4) casing pvc, 220 feet
 (material) (depth)
 (size) if telescope see back.
- (5) screen 7 ft, 113 feet
 (length) (depth to top)
4" gravel wall
 (size) (material)
- (6) pump 3/4 14
 (HP) (yield gpm)
 (type power)
- (7) electric log elect
 (yes or no)
 (organization running log)
- (8) how well bottom plugged 4" Conf.

CODED


AUG 17 1972

DRILLERS REMARKS:

MISS. RD. OF
 WATER COMMISSIONERS

If well telescopes please sketch and show depths.

GROUND LEVEL

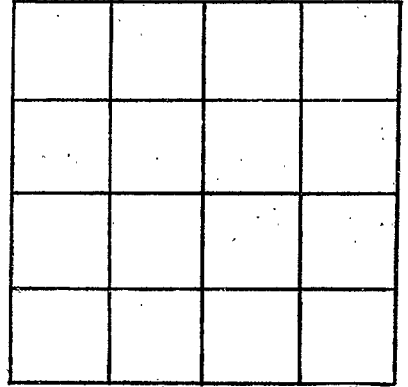

SECTION _____

Please indicate well location X.

ADDITIONAL INFORMATION

If more than one screen,
show locations of each on sketch.