

Marshall
 05
 4-25-68

MISSISSIPPI
 BOARD OF WATER COMMISSIONERS
 416 North State Street
 Jackson, Mississippi 39201

CODED

WATER WELL DRILLERS LOG

4-25-1968 A. B. Brown & Fort Marshall
 date well completed firm name county well located

LANDOWNER:

Farmers Tractor

description of formations encountered

from

to

Co. Nally Spring Miss.
 (mailing address)

red clay
 red sand
 white sand

0 15
 15 90
 90 190

WELL LOCATION:

sec. 1 T 4 N R 3 E
 (S) (W)
 1/2 miles N.W. of Nally Spring
 (distance) (direction) (nearest town)

WELL PURPOSE:

(home, irrigation, municipal, industrial)

WELL COMPLETION DATA:

(1) diameter (inches) 4"
 (2) total depth (feet) 190
 (3) static water level (feet) 90 below top of ground.

CODED

(4) casing P.V.C. 180
 (material) (depth)

(size) If telescope see back.

(5) screen 10 180-190
 (length) (depth to top)

(size) (material)

(6) pump 1/2 20
 (HP) (yield gpm)


elec.
 (type power)

(7) electric log NO
 (yes or no)

(organization running log)

(8) how well bottom plugged cap

DRILLERS REMARKS:

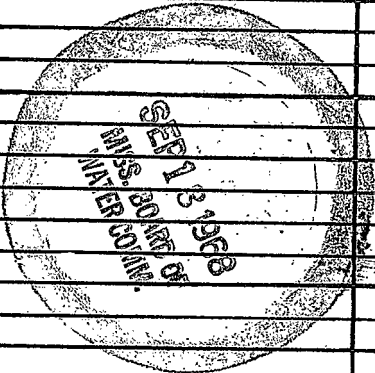

If well telescopes please
sketch and show depths.

GROUND LEVEL

SECTION _____

Please indicate well location X.

ADDITIONAL INFORMATION

If more than one screen,
show locations of each on sketch.