

Atkinson & Frost

MISSISSIPPI
BOARD OF WATER COMMISSIONERS
416 North State Street
Jackson, Mississippi 39201

CODED

WATER WELL DRILLERS LOG

Marshall
06
7-1548

7-15 1968 Father's Jones Marshall
date well completed firm name county well located

LANDOWNER:

description of formations encountered

from

to

Red Clay 0 15
White Clay 15 160
White Sand 160 200

(mailing address)

WELL LOCATION:

sec. 1 T 4 N R. 3 E
2 miles W of Staley Springs
(distance) (direction) (nearest town)

WELL PURPOSE:

(home, irrigation, municipal, industrial)

WELL COMPLETION DATA:

(1) diameter (inches) 4"
(2) total depth (feet) 200
(3) static water level (feet) 160 below above top of ground.

(4) casing (material) (depth)

(size) If telescope see back.

(5) screen 10 190
(length) (depth to top)

(size) (material)

(6) pump 3/4 12
(HP) (yield gpm)
230
(type power)

(7) electric log NO
(yes or no)


(organization running log)

(8) how well bottom plugged

DRILLERS REMARKS:


BOE COSSA

CODED

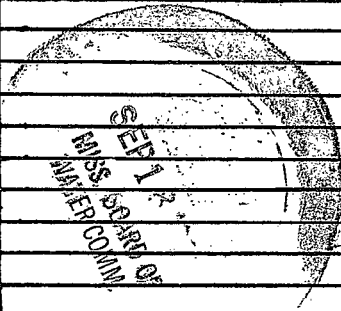

If well telescopes please sketch and show depths.

GROUND LEVEL

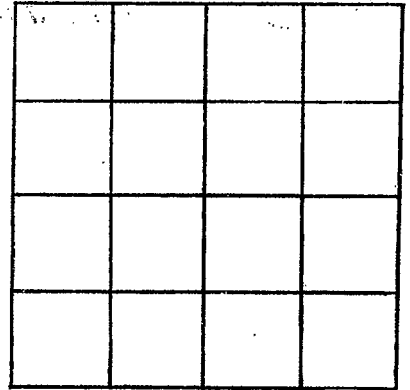

SECTION _____

Please indicate well location X.

ADDITIONAL INFORMATION

If more than one screen, show locations of each on sketch.