

Marshall  
 07  
 9-68

MISSISSIPPI  
 BOARD OF WATER COMMISSIONERS  
 416 North State Street  
 Jackson, Mississippi 39201

WATER WELL DRILLERS

**CODED**

Sept. 7, 1968 Rumpas Well Co. - Marshall  
 date well completed firm name county well located

LANDOWNER: Gomez, J. Cab  
RH R K.S.

description of formations encountered	from	to
<u>Clay</u>	<u>0</u>	<u>180</u>
<u>Sand</u>	<u>180</u>	<u>240</u>

(mailing address)

WELL LOCATION:

sec. 36 T. 4 N. R. 3 E.  
4 miles South of Holly Springs  
 (distance) (direction) (nearest town)


WELL PURPOSE:

(home, irrigation, municipal, industrial)

WELL COMPLETION DATA:

- (1) diameter (inches) 4"
- (2) total depth (feet) 240
- (3) static water level (feet) 140 <sup>below</sup>/<sub>above</sub> top of ground.
- (4) casing 4" plastic 233  
 (material) (depth)
- 4"  
 (size) if telescope see back.
- (5) screen 2ft. 233  
 (length) (depth to top)
- 4" gravel wall  
 (size) (material)
- (6) pump 3/4 10  
 (HP) (yield gpm)
- Elect.  
 (type power)
- (7) electric log \_\_\_\_\_  
 (yes or no)
- \_\_\_\_\_  
 (organization running log)
- (8) how well bottom plugged 4" cap


**CODED**

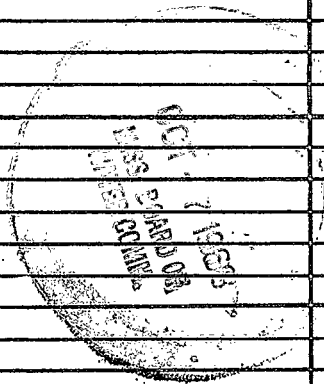

DRILLERS REMARKS:

If well telescopes please sketch and show depths.

GROUND LEVEL

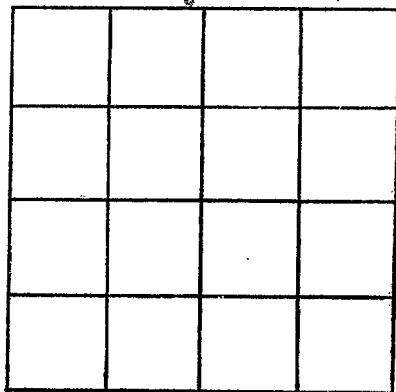

SECTION \_\_\_\_\_

Please indicate well location X.

ADDITIONAL INFORMATION

If more than one screen,  
show locations of each on sketch.