

MARSHALL
 08
 4-3-72

MISSISSIPPI
 BOARD OF WATER COMMISSIONERS
 416 North State Street
 Jackson, Mississippi 39201

CODED

WATER WELL DRILLERS LOG

April 3 1972 Atkinson & Frost Marshall
 date well completed firm name county well located

LANDOWNER:
 Artwell Craft
 Holly Springs Miss
 (mailing address)

description of formations encountered	from	to
brown clay	0	20
red sand	20	100
Clay	100	101
white sand	101	158

WELL LOCATION:
 sec. 4 T 4 N R 3 E
 5 miles E of Marion
 (distance) (direction) (nearest town)

WELL PURPOSE: Home
 (home, irrigation, municipal, industrial)

- WELL COMPLETION DATA:
- (1) diameter (inches) 4"
 - (2) total depth (feet) 158
 - (3) static water level (feet) 124 below top of ground.
 - (4) casing P.V.C. (material), (depth) (size) if telescope see back.
 - (5) screen 10 (length), (depth to top) (size) (material)
 - (6) pump 3/4 (HP), 10 (yield gpm)
 Elec. (type power)
 - (7) electric log 10 (yes or no)
 (organization running log)
 - (8) how well bottom plugged CAP.

CODED


APR 12 1972

MISS. Bd. WATER CONTROL

DRILLERS REMARKS:

If well telescopes please sketch and show depths.

GROUND LEVEL

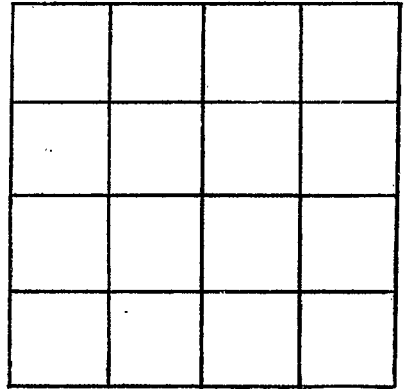

SECTION _____

Please indicate well location X.

ADDITIONAL INFORMATION

If more than one screen, show locations of each on sketch.