

**MARSHALL**  
 09  
 4-11-72

MISSISSIPPI  
 BOARD OF WATER COMMISSIONERS  
 416 North State Street  
 Jackson, Mississippi 39201

WATER WELL DRILLERS LOG

**CODED**

4-11

1972

C. & H. Well Co.

MARSHALL

date well completed

firm name

county well located

LANDOWNER: Leon Crow

Holly Springs, Miss

(mailing address)

description of formations encountered

from

to

Red CLAY	0	15
Red SAND	15	90
White SAND	90	175

WELL LOCATION:

sec. 23 T. 4 N. R. 3 E

4 miles SE of Holly Springs  
 (distance) (direction) (nearest town)

WELL PURPOSE: Home  
 (home, irrigation, municipal, industrial)

WELL COMPLETION DATA:

- (1) diameter (inches) 4"  
 (2) total depth (feet) 175  
 (3) static water level (feet) 109 below above top of ground.

(4) casing Plastic, 16.5  
 (material) (depth)

(size) if telescope see back.

(5) screen 10' 155  
 (length) (depth to top)  
4" Plastic  
 (size) (material)

(6) pump 3/4 10GPM  
 (HP) (yield gpm)

220 Fico  
 (type power)

(7) electric log NO  
 (yes or no)

(organization running log)

(8) how well bottom plugged CAP

**CODED**


APR 12 1972

DRILLERS REMARKS:

MISS. BD. OF  
 WATER COM.

If well telescopes please sketch and show depths.

GROUND LEVEL

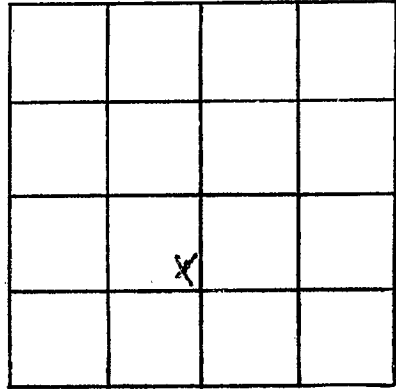

SECTION 22

Please indicate well location X.

ADDITIONAL INFORMATION

If more than one screen,  
show locations of each on sketch.