

Marshall

Ø 12

2-5-70

MISSISSIPPI
 BOARD OF WATER COMMISSIONERS
 416 North State Street
 Jackson, Mississippi 39201

WATER WELL DRILLERS LOG

FILED

2-5-70

date well completed

Atkinson & Frost Marshall

firm name

county well located

LANDOWNER:

H.P. Bradford

Holly Springs Miss
(mailing address)

WELL LOCATION:

sec. 7 T. 4 N R. 3 E
 4 miles S.E. of Holly Springs
 (distance) (direction) (nearest town)

WELL PURPOSE: home
 (home, irrigation, municipal, industrial)

WELL COMPLETION DATA:

- (1) diameter (inches) 4
- (2) total depth (feet) 240
- (3) static water level (feet) 180 below above top of ground:
- (4) casing P.V.C. 240 (material) (depth)
(size) If telescope see back.
- (5) screen 10ft. 230 (length) (depth to top)
(size) (material)
- (6) pump 3/4 10 (HP) (yield gpm)
elec (type power)
- (7) electric log (yes or no)
(organization running log)
- (8) how well bottom plugged OHP

description of formations encountered

from to

red clay	0	18
red sand	18	53
white clay	53	75
white sand	75	175
white clay	175	180
white sand	180	240

FILED


MAR 6 - 1970

MISS. DIV. OF WATER COMMISSIONERS

DRILLERS REMARKS:

If well telescopes please sketch and show depths.

GROUND LEVEL

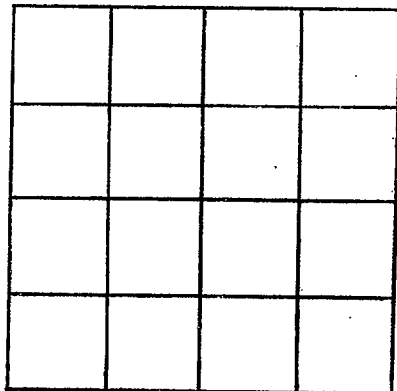

SECTION _____

Please indicate well location X.

ADDITIONAL INFORMATION

If more than one screen,
show locations of each on sketch.