

MARSHALL
Ø18
9-28-70

MISSISSIPPI
 BOARD OF WATER COMMISSIONERS
 416 North State Street
 Jackson, Mississippi 39201

CODED

WATER WELL DRILLERS LOG

9-28 1970 Rumpas Well Co. Marshall
 date well completed firm name county well located

LANDOWNER:
Raymond Jones
Deely Springs, MS 39
 (mailing address)

description of formations encountered	from	to
	<u>clay</u>	<u>0</u>
<u>sand</u>	<u>20</u>	<u>60</u>
<u>clay</u>	<u>60</u>	<u>80</u>
<u>sand</u>	<u>80</u>	<u>120</u>

WELL LOCATION:
 sec. 3 T. 4 N. R. 3 E.
5 miles West of H.S.
 (distance) (direction) (nearest town)

WELL PURPOSE: Drinking
 (home, irrigation, municipal, industrial)

WELL COMPLETION DATA:
 (1) diameter (inches) 4
 (2) total depth (feet) 120 feet
 (3) static water level (feet) 50 feet below above top of ground.
 (4) casing PVC 120 feet
 (material) (depth)
 (size) if telescope see back.

CODED

(5) screen 6 ft 11 ft
 (length) (depth to top)
gravel wall
 (size) (material)
 (6) pump 3/4 10
 (HP) (yield gpm)

(type power)
 (7) electric log Elect
 (yes or no)


(organization running log)
 (8) how well bottom plugged 4" cap

DRILLERS REMARKS:

DATE: 10 1970
 MISSISSIPPI BOARD OF WATER COMMISSIONERS

If well telescopes please sketch and show depths.

GROUND LEVEL

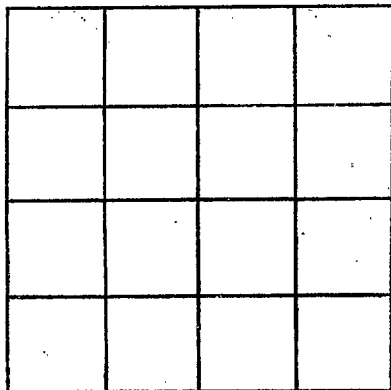

SECTION _____

Please indicate well location X.

ADDITIONAL INFORMATION

If more than one screen, show locations of each on sketch.