

MARSHALL

019

5-25-73

MISSISSIPPI BOARD OF WATER COMMISSIONERS
416 North State Street
Jackson, Mississippi 39201

CODED

WATER WELL DRILLERS LOG

5-25 1973 Don & Kay Bumpers well Marshall
date well completed firm name county well located

LANDOWNER: Milton Falkner
Holly Springs, Miss
(mailing address)

description of formations encountered	from	to
	<u>sand</u>	<u>0</u>
<u>clay</u>	<u>80</u>	<u>90</u>
<u>sand</u>	<u>90</u>	<u>200</u>

WELL LOCATION:
sec 36 T 4 N R 3 E
6 miles South of Holly Springs
(distance) (direction) (nearest town)

WELL PURPOSE: Driller
(home, irrigation, municipal, industrial)

- WELL COMPLETION DATA:
- (1) diameter (inches) 4"
 - (2) total depth (feet) 200 feet
 - (3) static water level (feet) 125 feet ^{below} / _{above} top of ground.
 - (4) casing prc 200 feet
(material) (depth)
 - (size) If telescope see back.
 - (5) screen 74" 193 feet
(length) (depth to top)
 - 4" gravel wall
(size) (material)
 - (6) pump 3/4 14
(HP) (yield/gpm)
 - (type power)
 - (7) electric log elect.
(yes or no)
 - (organization running log)
 - (8) how well bottom plugged 4" cap.

CODED


DRILLERS REMARKS:

8 1973

MISS. BD. 0

If well telescopes please sketch and show depths.

GROUND LEVEL

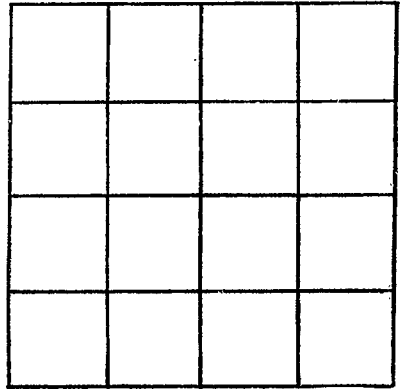

SECTION _____

Please indicate well location X.

ADDITIONAL INFORMATION

If more than one screen,
show locations of each on sketch.