

MARSHALL
 Ø 20
 6-3-73

MISSISSIPPI
 BOARD OF WATER COMMISSIONERS
 416 North State Street
 Jackson, Mississippi 39201

CODED

WATER WELL DRILLERS LOG

6-3-1973 Links Bros. Wells Marshall
 date well completed firm name county well located

LANDOWNER: Rubenn Mann - Holly Springs, Miss.
 (mailing address)

description of formations encountered	from	to
Red clay	0	15
Red sand	15	60
White Clay & Sand	60	19.5
White Sand	19.5	225

WELL LOCATION:
 sec. 3 T. 4 N. R. 3
 (distance) miles W. (direction) of Holly Springs (nearest town)

WELL PURPOSE: Drainage
 (home, irrigation, municipal, industrial)

- WELL COMPLETION DATA:
- (1) diameter (inches) 4"
 - (2) total depth (feet) 225 ft
 - (3) static water level (feet) 156 below above top of ground.
 - (4) casing Plastic, 225
 (material) (depth)
 (size) If telescope see back.
 - (5) screen 4 ft, 221
 (length) (depth to top)
4 in. Stravel
 (size) (material)
 - (6) pump 3/4 10 GPM
 (HP) (yield gpm)
Electric 220
 (type power)
 - (7) electric log NO
 (yes or no)
 (organization running log)
 - (8) how well bottom plugged Cap

CODED


JUN 21 1973

DRILLERS REMARKS:

MISS. BD. OF
 WATER COMMISSIONERS

If well telescopes please
sketch and show depths.

GROUND LEVEL

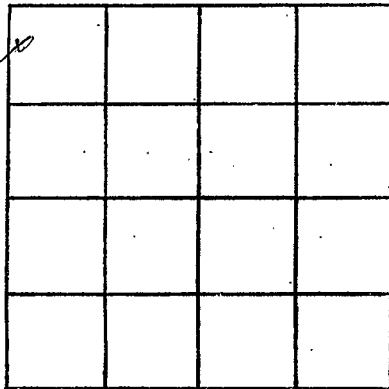

SECTION 3

Please indicate well location X.

ADDITIONAL INFORMATION

If more than one screen,
show locations of each on sketch.