

CODED

MISSISSIPPI
BOARD OF WATER COMMISSIONERS
416 North State Street
Jackson, Mississippi 39201

WATER WELL DRILLERS LOG

MARSHALL
Ø 21
7-13-73

7-13
date well completed

73 Hicks Bassville
firm name

Marshall
county well located

LANDOWNER: Clarence
London - Rt 5 Box 215
Gally Springs, Miss
(mailing address)

description of formations encountered	from	to
		15
Red Clay	0	30
Red Sand	15	30
Red Sand	30	60
White Sand	60	75
Red Sand	75	150
White Sand	150	165
White Clay	165	180
White Clay Sand	180	190
White Sand	190	230

WELL LOCATION:
sec 23 T 4 N R 3 E
3 miles (distance) W (direction) of Gally Springs (nearest town)

WELL PURPOSE: Home
(home, irrigation, municipal, industrial)

- WELL COMPLETION DATA:
- (1) diameter (inches) 4"
 - (2) total depth (feet) 230
 - (3) static water level (feet) 160 below top of ground.
 - (4) casing Plastic (material) 230 (depth)
 - (size) If telescope see back.
 - (5) screen 4 (length) 226 (depth to top)
 - 4" (size) Gravel (material)
 - (6) pump 3/4 (HP) 10 GPM (yield gpm)
 - Electric (type power) 220
 - (7) electric log NO (yes or no)

CODED


(organization running log)
(8) how well bottom plugged Cap

DRILLERS REMARKS:

JUL 25 1973

If well telescopes please sketch and show depths.

GROUND LEVEL

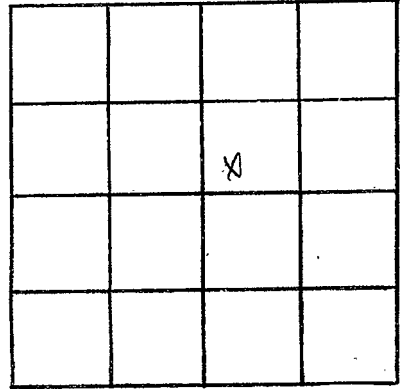

SECTION 23

Please indicate well location X.

ADDITIONAL INFORMATION

If more than one screen,
show locations of each on sketch.