

MARSHALL  
 022  
 11-16-72

MISSISSIPPI  
 BOARD OF WATER COMMISSIONERS  
 416 North State Street  
 Jackson, Mississippi 39201

**CODED**

WATER WELL DRILLERS LOG

Nov. 16 1972 R L Carpenter Marshall  
 date well completed firm name county well located

LANDOWNER: Sproull Chapel Church  
 Hwy no. 4  
 Holly Springs, Miss  
 (mailing address)

WELL LOCATION:  
 sec. 33 T. 4 N. R. 3 E.  
6 miles southwest of Holly Springs  
 (distance) (direction) (nearest town)

WELL PURPOSE: church  
 (home, irrigation, municipal, industrial)

WELL COMPLETION DATA:

- (1) diameter (inches) 4
- (2) total depth (feet) 170
- (3) static water level (feet) 80 below top of ground.
- (4) casing Plastic 164 ft.  
 (material) (depth)  
 (size) if telescope see back.
- (5) screen 6 ft. 164 ft.  
 (length) (depth to top)  
1/2" Plastic & Band  
 (size) (material)
- (6) pump 1/2 8  
 (HP) (yield gpm)  
Elec.  
 (type power)
- (7) electric log no.  
 (yes or no)  
 (organization running log)
- (8) how well bottom plugged Plastic

| description of formations encountered | from | to  |
|---------------------------------------|------|-----|
| Surface Soil                          | 5    | 12  |
| Brown Sand                            | 12   | 29  |
| Red coarse sand                       | 29   | 60  |
| Med. white sand                       | 60   | 126 |
| White Clay                            | 126  | 135 |
| White coarse sand                     | 135  | 170 |


**CODED**

DRILLERS REMARKS:

NOV 30 1972

If well telescopes please sketch and show depths.

GROUND LEVEL

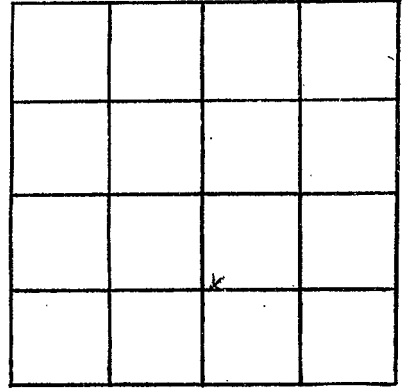

SECTION 83

Please indicate well location X.

ADDITIONAL INFORMATION

If more than one screen,  
show locations of each on sketch.