

24
 MARSHALL
 5-8-73

MISSISSIPPI
 BOARD OF WATER COMMISSIONERS
 416 North State Street
 Jackson, Mississippi 39201

CODED

WATER WELL DRILLERS LOG

May 8 1973 R. L. Carpenter Marshall
 date well completed firm name county well located

LANDOWNER: Kate Jones
 Holly Springs,
 Miss.
 (mailing address)

WELL LOCATION:
 sec. 4 T. 4 N. R. 3 E.
 3 miles west of Holly Springs
 (distance) (direction) (nearest town)

WELL PURPOSE: Home
 (home, irrigation, municipal, industrial)

- WELL COMPLETION DATA:
- (1) diameter (inches) 4
 - (2) total depth (feet) 180
 - (3) static water level (feet) 128 below top of ground.
 - (4) casing Plastic 174 ft (material) (depth)
 - (size) if telescope see back.
 - (5) screen 6 ft 174 ft (length) (depth to top)
 - 4 in. Plastic Sand (size) (material)
 - (6) pump 3/4 10 (HP) (yield gpm)
 - 9 sec. (type power)
 - (7) electric log No (yes or no)
 - (organization running log)
 - (8) how well bottom plugged Plastic cap


description of formations encountered	from	to
Surface Soil	0	24
med. Red. Sand	24	40
med. white sand	40	94
white clay & white fine sand	94	120
med. white sand	120	145
white coarse sand	145	180

DRILLERS REMARKS:

AUG 17 1973

If well telescopes please sketch and show depths.

GROUND LEVEL

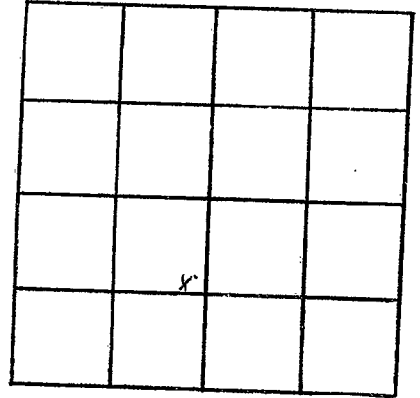

SECTION 4

Please indicate well location X.

ADDITIONAL INFORMATION

If more than one screen,
show locations of each on sketch.