

MARSHALL
 Ⓟ 26
 8-20-73

MISSISSIPPI
 BOARD OF WATER COMMISSIONERS
 416 North State Street
 Jackson, Mississippi 39201

CODED 1973
 MISS. BD. OF
 WATER COMMISSIONERS

WATER WELL DRILLERS LOG

8-22-1973 date well completed
 B. Gibbs Sons Well firm name
 Marshall county well located

LANDOWNER: Mosuria
 Jeffries - Rt 5 Box 21
 Rt 5 Box 21, H.S.
 (mailing address) Miss

WELL LOCATION:
 sec 23 T 4 N R 3 E
 4 miles SW of H.S.
 (distance) (direction) (nearest town)

WELL PURPOSE: Home
 (home, irrigation, municipal, industrial)


WELL COMPLETION DATA:
 (1) diameter (inches) 4 in
 (2) total depth (feet) 290
 (3) static water level (feet) 200 below top of ground.
 (4) casing Plastic, 290 (material) (depth)
 (size) if telescope see back.
 (5) screen 5 ft, 285 (length) (depth to top)
 1/2" Screen (size) (material)
 (6) pump 3/4 HP, 10 (HP) (yield gpm)
 Electric 220 (type power)
 (7) electric log No (yes or no)
 (organization running log)
 (8) how well bottom plugged Cap

description of formations encountered	from	to
Red Sand	0	30
Red Sand + white	30	45
white Sand + clay	45	60
white clay	60	75
white Sand + clay	75	105
white Sand	105	180
white Sand + clay	180	210
white clay	210	220
white Sand + clay	220	230
white clay	230	250
white Sand	250	290

DRILLERS REMARKS:

If well telescopes please sketch and show depths.

GROUND LEVEL

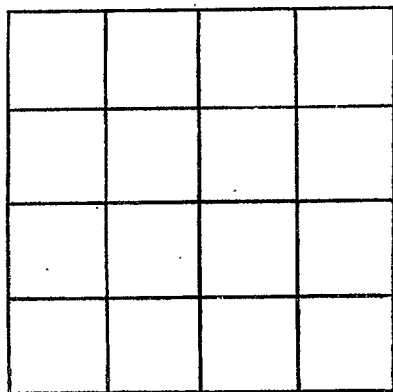

SECTION _____

Please indicate well location X.

ADDITIONAL INFORMATION

If more than one screen,
show locations of each on sketch.