

MARSHALL
021
3-8-74


MISSISSIPPI
 BOARD OF WATER COMMISSIONERS
 416 North State Street
 Jackson, Mississippi 39201 **CODED**

WATER WELL DRILLERS LOG

March 8 1974 R. L. Carpenter Marshall
 date well completed firm name county well located

LANDOWNER: <u>Marshall Suggs</u>	description of formations encountered	from	to
<u>Holly Springs</u>	<u>surface soil</u>	<u>0</u>	<u>18</u>
<u>Travis, RFD</u> (mailing address)	<u>med Red Soil</u>	<u>18</u>	<u>30</u>
WELL LOCATION: sec <u>27</u> T <u>4</u> N R <u>3</u> E <u>5</u> miles <u>S</u> of <u>Holly Springs</u> (distance) (direction) (nearest town)	<u>Red coarse sand</u>	<u>30</u>	<u>45</u>
WELL PURPOSE: <u>Home & some</u> (home, irrigation, municipal, industrial)	<u>med white sand</u>	<u>45</u>	<u>90</u>
WELL COMPLETION DATA:	<u>white clay</u>	<u>90</u>	<u>102</u>
(1) diameter (inches) <u>4</u>	<u>med white sand</u>	<u>102</u>	<u>175</u>
(2) total depth (feet) <u>265</u>	<u>white fine sand</u>	<u>175</u>	<u>240</u>
(3) static water level (feet) <u>127</u> above top of ground.	<u>clay</u>		
(4) casing <u>Plastic</u> , <u>259 ft.</u> (material) (depth)	<u>white coarse sand</u>	<u>240</u>	<u>265</u>
(size) if telescope see back.			
(5) screen <u>2 ft.</u> , <u>259 ft.</u> (length) (depth to top)			
<u>4 in</u> , <u>Plastic & Gravel</u> (size) (material)			
(6) pump <u>3/4</u> <u>10</u> (HP) (yield gpm)			
<u>1 hp</u> (type power)			
(7) electric log <u>no.</u> (yes or no)			
(organization running log)			
(8) how well bottom plugged <u>Plastic cap</u>			
DRILLERS REMARKS:			

CODED

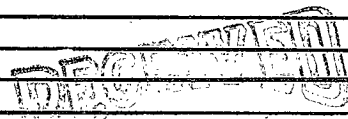

MAR 12 1974
 MISS. BD. OF WATER COMMISSIONERS

If well telescopes please sketch and show depths.

GROUND LEVEL

	x		

SECTION 27

Please indicate well location X.

ADDITIONAL INFORMATION

If more than one screen, show locations of each on sketch.