

MISSISSIPPI
BOARD OF WATER COMMISSIONERS
416 North State Street
Jackson, Mississippi 39201

CODED

WATER WELL DRILLERS LOG

MARSHALL
Ø 29
3-22-74

5-22-1974 date well completed
Blanks Bone Wells firm name
Marshall county well located

LANDOWNER:
Maxima Jeffries
Rt 5, Blanks Springs, MS
(mailing address)

description of formations encountered	from	to
Red Clay	0	20
Red Sand	20	35
Red Sand & Clay	35	65
White Sand	65	140
White Sand & Clay	140	275
White Sand	275	322

WELL LOCATION:
sec 23 T 4 N R 3 E
4 miles SW of Holly Springs
(distance) (direction) (nearest town)

WELL PURPOSE: Home
(home, irrigation, municipal, industrial)

WELL COMPLETION DATA:

(1) diameter (inches) 4 1/2
(2) total depth (feet) 322
(3) static water level (feet) 147 below top of ground.
(4) casing Plastic, 322 (material) (depth)
If telescope see back.
(5) screen 4 ft, 3 1/8 (length) (depth to top)
4 1/2, Gravel (size) (material)
(6) pump 3/4 10 (HP) (yield gpm)
Electric 1/20 (type power)
(7) electric log No (yes or no)
(organization running log)
(8) how well bottom plugged Cap


CODED

DRILLERS REMARKS:

APR 25 1974

If well telescopes please sketch and show depths.

GROUND LEVEL

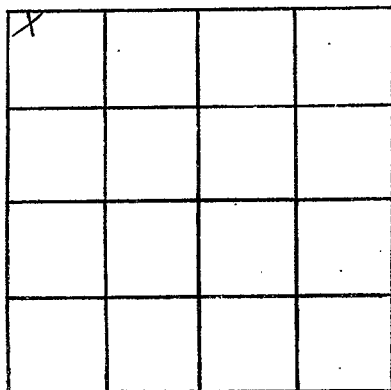

SECTION 23

Please indicate well location X.

ADDITIONAL INFORMATION

If more than one screen,
show locations of each on sketch.