

MISSISSIPPI  
 BOARD OF WATER COMMISSIONERS **CODED**  
 416 North State Street  
 Jackson, Mississippi 39201

**WATER WELL DRILLERS LOG**

**MARSHALL**  
 D 31  
 3-14-74

March 14 1974 Robert W. Wilson Marshall  
 date well completed firm name county well located

**LANDOWNER:**  
 Madena Malone  
 Holly Springs Miss.  
 (mailing address)

**WELL LOCATION:**  
 sec. 23 T. 4 N. R. 3 E.  
 (distance) miles (direction) of (nearest town)

**WELL PURPOSE:**  
 (home, irrigation, municipal, industrial)

**WELL COMPLETION DATA:**

(1) diameter (inches) 4

(2) total depth (feet) 157

(3) static water level (feet) \_\_\_\_\_ below above top of ground.

(4) casing \_\_\_\_\_ (material), \_\_\_\_\_ (depth),  
 \_\_\_\_\_ (size) If telescope see back.

(5) screen \_\_\_\_\_ (length), \_\_\_\_\_ (depth to top)  
 \_\_\_\_\_ (size), \_\_\_\_\_ (material) gravel packed

(6) pump 3/4 (HP), 10 (yield gpm)  
electric power (type power)

(7) electric log \_\_\_\_\_ (yes or no)  
 \_\_\_\_\_ (organization running log)

(8) how well bottom plugged 4" plaster cap


description of formations encountered	from	to
Red Clay, Red Sand	0	30
Red Sand, white clay	30	60
Red Sand	60	105
Red sand, white clay	105	120
white clay, white sand	120	135
white sand	135	160

**DRILLERS REMARKS:**

DRILLERS SIGNATURE  
 DATE 7 1974

If well telescopes please sketch and show depths.

GROUND LEVEL

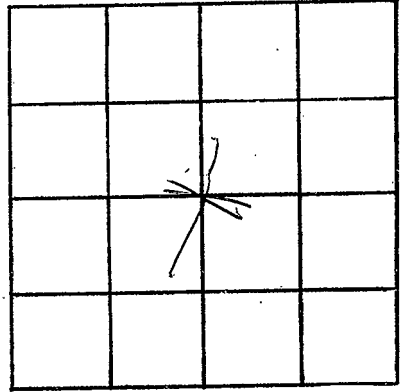

SECTION 23

Please indicate well location X.

ADDITIONAL INFORMATION

If more than one screen,  
show locations of each on sketch.