

MISSISSIPPI
BOARD OF WATER COMMISSIONERS
416 North State Street
Jackson, Mississippi 39201

WATER WELL DRILLERS LOG

CODED

MARSHALL

Φ 36

11-15-74

11-15-1974 date well completed Robert Wilburn firm name Marshall county well located

LANDOWNER:

Leslie Ruard

description of formations encountered

from to

Holly Springs, Miss.
C (mailing address)

red clay, red sand	0	30
red sand	30	90
red sand, white clay	90	120
white clay, red sand	120	135
blue clay	135	165
white sand	165	240

WELL LOCATION:

sec. 27 T 4 N R 3 E
 (distance) miles of (direction) (nearest town)

WELL PURPOSE:

(home, irrigation, municipal, industrial)

WELL COMPLETION DATA:

- (1) diameter (inches) 4
- (2) total depth (feet) 237
- (3) static water level (feet) 120 below above top of ground.
- (4) casing (material) 233 (depth)
4 (size) If telescope see back.
- (5) screen (length) 4 (depth to top)
4 (size) spawl packed (material)
- (6) pump (HP) _____ (yield gpm)
electric (type power)
- (7) electric log (yes or no) _____
 _____ (organization running log)
- (8) how well bottom plugged 4"
plastic cap

CODED


REGISTERED
 125
 115

JAN 24 1975

DRILLERS REMARKS:

If well telescopes please sketch and show depths.

GROUND LEVEL

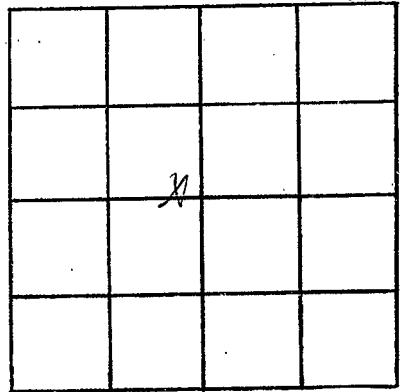

SECTION 27

Please indicate well location X.

ADDITIONAL INFORMATION

If more than one screen,
show locations of each on sketch.